

AMITE MISSISSIPPI BOARD OF WATER COMMISSIONERS

T⁹

4457

8-11-64 WATER WELL DRILLERS LOG

CODED

Date: 8-11, 1964, Driller: Chester Keene County Amite
(Name)

		Description & Color of Materials Sand, Clay, Red Clay, Shell, etc.	Thick- ness Feet	Depth Feet
(1) Owner of Land:	Thad Leggett (Name) Magnolia (Address)	Hard surface clay	15	15
(2) Location:	1/4, 1/4, Sec. 3 T. 1 R. 5 4 miles North of Sallis (distance) (direction) (Nearest Town)	Red sand Sand & gravel	65 25	80 105
(3) Topography:	Hilly (Hilly) (Flat) (Level)			
(4) Purpose of Well:	Farm (Domestic Irrigation Municipal, Industrial, Other)			

CODED

Information upon completion of well:

(1) Diameter 4 inches.

(2) Total Depth 105 feet.

(3) Water Level 80 feet below top of ground.

(4) Cased to bottom size 4"


(5) Screen: Size 4", Length 2'

(6) Were any formations sealed against pollution?
_____ yes, _____ no.

If YES depth of formation _____

Why _____

Drillers Remarks: New well location

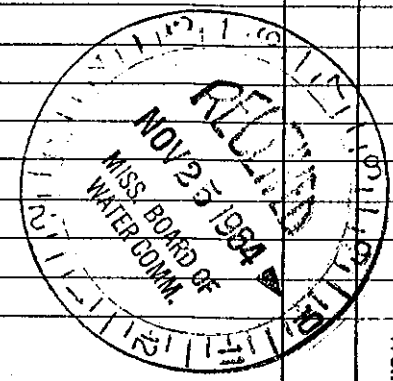

Well No.

(Use Back Side)

Mail this copy to Board of Water Commissioners 429 Miss. St. Jackson, Miss.