

Top of lap pipe or reduction in casing: _____ feet. *If telescoped or more than one screen, describe on next page.*

Other (describe): _____

Type of completion (circle all applicable): Gravel packed Underrammed Telescoped Open hole Natural Development

Screen slot size: _____ inches Setting depth: From _____ feet to _____ feet

Screen length: _____ feet Screen diameter: _____ inches Type of screen: PVC

Casing length: _____ feet Casing diameter: _____ inches Type of casing: PVC

Well depth: 130 Well grouted to a depth of 10 feet Type of grout (circle one): Neat Cement Bentonite Mix

Method of Measurement (circle one): Electric tape electric tape air line other: _____

Static Water Level: _____ feet above or below (circle one) land surface Date measured: 8-13-07

If a flowing well, method of flow regulation: Valve _____ Other (describe): _____

Purpose of Well (check one): Home Industrial _____ Public Supply _____ Irrigation _____ Fish Culture _____ Other: _____

If drilling is not related to water well construction, fill the remainder of this block.

Seismic Survey _____ Other (describe): _____

Purpose of borehole (check one): Water Well Geotechnical/Geological Investigation _____ Ground Source Heat Pump _____

Logs run (circle all applicable): No logs run Electric Gamma Ray Density Sonic Neutron Other: _____

Method of dosing and volume of Chlorine used in drilling and development: _____

Location of the source of any surface water used for drilling: _____

Date drilling started: 8-13-07 Date drilling completed: 8-13-07 Hole depth: 130 Hole diameter: 7"

Well / Borehole Data

<p>Telephone No. () _____</p> <p>City <u>Gibson</u> State <u>MS</u> Zip Code _____</p> <p>Mailing Address: <u> Hwy 568</u></p> <p>Owner Name <u>Jeff Pittman</u></p> <p>(Landowner if borehole is not for a water well)</p>	<p>Well or Borehole Location</p> <p>Latitude: <u>31° 0' 20.5"</u> Longitude: <u>90° 41' 31.3"</u></p> <p>Method of Lat/Long (circle one): <u>Conventional Survey</u>, _____</p> <p>USGS quad, Hand-held GPS, Survey-grade GPS _____</p> <p>NE 1/4 SW 1/4 Sec. <u>34</u>, Twn. <u>1N</u>, Rng. <u>5E</u></p> <p>Distance _____ Miles _____ Direction _____ of _____ Nearest Town _____</p>
--	---

State Law requires that this report be prepared by the license holder responsible for the work and filed with the Department at the above address within 30 days of completion of drilling of the well or borehole.

For Office Use Only:

Acquirer: T-63

Well #: _____

L. S. Elevation: _____

E-log #: _____

State Well Report
 Part 1 - Driller's Log
 Mississippi Department of Environmental Quality
 Office of Land and Water Resources
 P.O. Box 10631
 Jackson, MS 39289-0631
 (601)961-5210
 (601)354-6938 (fax)

County: Anne

Permit #: _____

Driller: Frederick Will

Date drilling completed: 8-13-07

T-63

The sketch below only required for water wells


If well telescopes, show depths on sketch

Ground Level →

Description of formations encountered must be provided for all wells and boreholes, unless specifically exempted by regulations

Description of Formations Encountered	From (depth)	To (depth)
	Ground Level	
Clay-	0	20
Clay-	20	40
Sand-	40	80
Clay-	80	100
Sand-	100	120
course sands	120	130

If more than one screen, show location of each on sketch

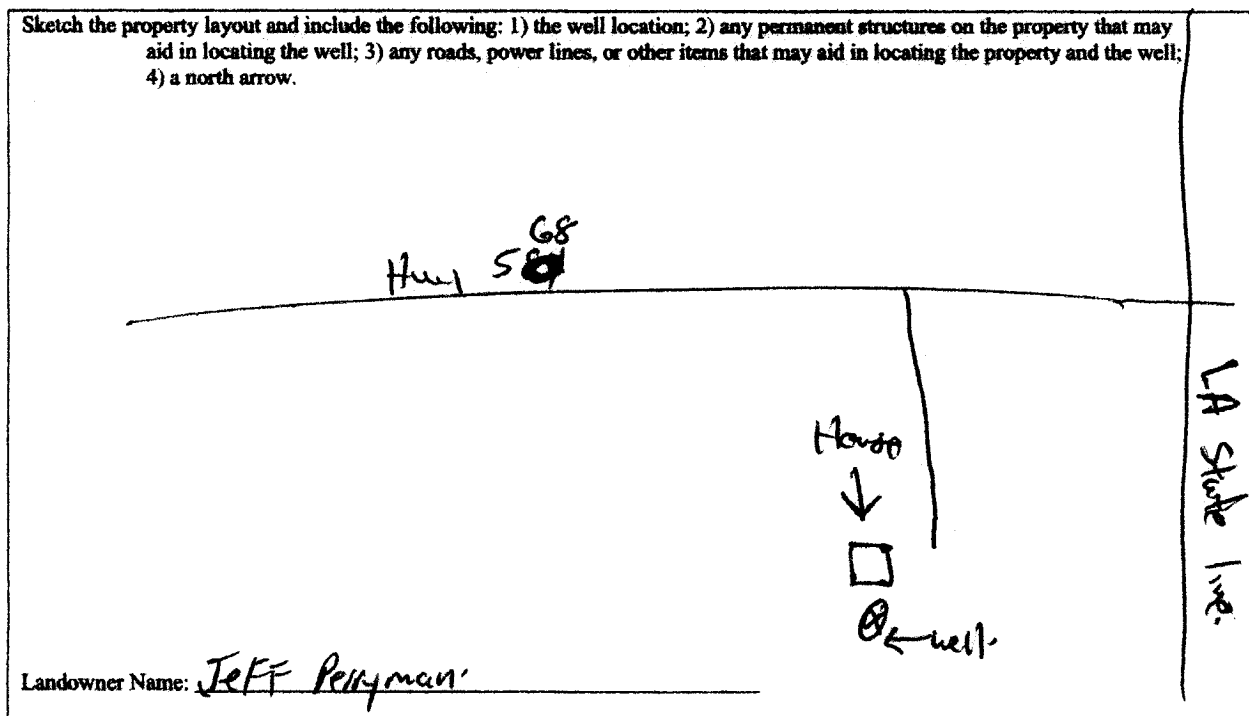

Form: OLWR-SWR-1A

I certify that the well/borehole was drilled, constructed, and completed in accordance with all applicable requirements of the Mississippi Department of Environmental Quality and the Mississippi Department of Health regulations, if applicable, and state laws.

Print Name of Responsible Licensee and License No. Bud Fitzgerald 029. Date 8-13-07. Signature of Licensee Bud Fitzgerald

STATE WELL REPORT

Part 2

Pump Installer's Completion Report
 Mississippi Department of Environmental Quality
 Office of Land and Water Resources
 P.O. Box 10631
 Jackson, MS 39289-0631
 (601)961-5210
 (601)354-6938 (fax)

County: Amite
 Permit #: _____
 Driller: Fitzgerald Well Service
 Date completed: 8-13-07
Copy information from block on Part 1

For Office Use Only:

Aquifer: _____
 Well #: T-63
 Elevation: _____

This part of the report must be completed by a licensed water well contractor or a licensed pump installer. A copy of Part 1 of the report must be attached and both parts filed with the Department at the above address within 30 days of well completion.

Well Owner Information	Well Location
Owner Name: <u>Jeff Perryman</u>	Latitude: <u>31° 0' 20.5"</u> Longitude: <u>90° 41' 31.3"</u>
Mailing Address: <u> Hwy 568</u>	Method of Lat/Long (check one): Conventional Survey _____
<u>Gilburg MS</u>	USGS quad _____, Hand-held GPS _____, Survey-grade GPS _____
City State Zip Code	_____ ¼ _____ ¼ Sec _____ T _____ R _____
Telephone No. (____) _____	Distance Direction Nearest Town
	_____ Miles _____ of _____

Pump Type Circle one	Power Type Circle one
Air Lift Jet <input checked="" type="radio"/> <u>Submersible</u>	Diesel Engine Gasoline Engine Natural Gas
Bucket Piston Turbine	<input checked="" type="radio"/> <u>Electric Motor</u> Hand Tractor PTO
Centrifugal Rotary Flowing Well	Windmill Other (specify): _____
Other (specify): _____	Horse Power Rating of Motor: <u>1/2</u>
Date Pump Installed: <u>8-13-07</u>	Setting Depth: <u>100'</u> feet
Rated Pump Capacity: <u>12</u> Gallons Per Minute	Number of Stages: <u>8</u>

Pump Test Data	Method of Measuring Water Level Circle one
Date Well Tested: _____	Air Line Electric Measuring Line <input checked="" type="radio"/> <u>Steel Tape</u>
Static Water Level (A): _____ Feet Below Land Surface	Other (specify): _____
Pumping Water Level (B): _____ Feet Below Land Surface	For flowing well, measured shut in head: _____ feet
Drawdown [(B) - (A)]: _____ Feet Below Land Surface	Well yielded _____ GPM with a drawdown of _____ feet after _____ hours of pumping
Test Pumping Rate: _____ Gallons Per Minute	
Duration of Pump Test (minimum 4 hours): _____ hours	

I HEREBY CERTIFY that the above statements are true to the best of my knowledge.

Brad Fitzgerald 024 Brad Fitzgerald
 Print Name of Pump Installer and License No. (if applicable) Signature of Pump Installer