


2014

AMITE  
T 2614  
02-13-81

MISSISSIPPI  
BOARD OF WATER COMMISSIONERS  
416 North State Street  
Jackson, Mississippi 39201

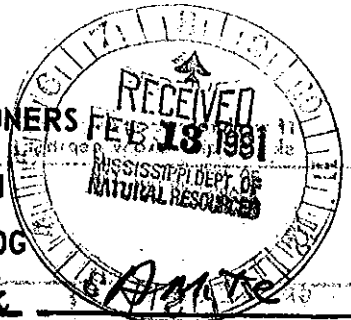

WATER WELL DRILLERS LOG

Rever Well Service

date well completed

firm name

county well located

LANDOWNER:	description of formations encountered	from	to
John Smith Rt 3 Magnolia (mailing address)			
<b>WELL LOCATION:</b>			
sec. 12 T 1 N R 35 E 5 1/2 miles E.N.E. of Collins (distance) (direction) (nearest town)			
<b>WELL PURPOSE:</b> Dairy (home, irrigation, municipal, industrial)			
<b>WELL COMPLETION DATA:</b>			
(1) diameter (inches) 4"			
(2) total depth (feet) 95'			
(3) static water level (feet) 15' below top of ground			
(4) casing plastic bottom (material) (depth)			
- If telescope see back.			
(5) screen 5' 90' (length) (depth to top)			
4" plastic (size) (material)			
(6) pump bealthus (HP) (yield gpm)			
shot (type power)			
(7) electric log no (yes or no)			
- (organization running log)			
(8) how well bottom plugged backwash valve			
<b>DRILLERS REMARKS:</b>			

DEPT. OF NATURAL RESOURCES  
BUREAU OF LAND & WATER RESOURCES

FEB 13 1981  
RECEIVED