

AMITE MISSISSIPPI BOARD OF WATER COMMISSIONERS

U1

3-12-62

WATER WELL DRILLERS LOG

CODED

Date: 3-12, 1962, Driller:

F. J. ...
 Dr. ...
 ... County Amite

(Name)

(1) Owner of Land: <i>Clyde Gordon</i> <small>(Name)</small>	Description & Color of Materials Sand, Clay, Red Clay, Shell, etc.	Thick- ness Feet	Depth Feet
<i>Osyka Rt 2 MISS</i> <small>(Address)</small>	0-20 <i>Top soil + clay</i>	0-20	
(2) Location: $\frac{1}{4}$, $\frac{1}{4}$, Sec. 18 T. 1 R. 6, <i>2</i> miles <i>E</i> of <i>Gills Bay</i> <small>(distance) (direction) (Nearest Town)</small>	<i>Red sand</i> <i>Sand + Red Chalk</i> <i>Heavy Gravel</i>	20-50 50-80 80-90	
(3) Topography: <input checked="" type="checkbox"/> <i>Level</i> <small>(Hilly) (Flat) (Level)</small>	<i>Coarse sand</i>	90-98	
(4) Purpose of Well: <i>Domestic</i> <small>(Domestic Irrigation Municipal, Industrial, Other)</small>	<i>Coarse sand + pebbles</i> <i>White halts</i>	98-105 105-	


Information upon completion of well:

- (1) Diameter *4* inches.
- (2) Total Depth *100* feet.
- (3) Water Level *50* feet below top of ground.
- (4) Cased to *94*, Size *4*.
- (5) Screen: Size *2"*, Length *4"*.
- (6) Were any formations sealed against pollution?
 yes, no.

If YES depth of formation _____

Why _____

Drillers Remarks: *Lots of pebbles below 80 ft.*

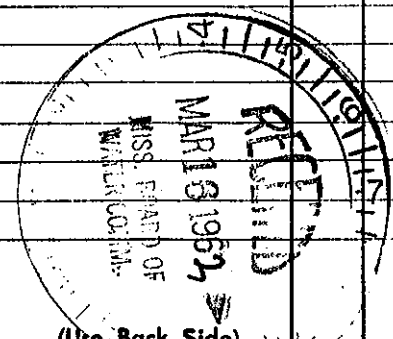

(Use Back Side)

Well No.

Mail this copy to Board of Water Commissioners 429 Miss. St. Jackson, Miss.