

AMITE

MISSISSIPPI BOARD OF WATER COMMISSIONERS

U7

4789

7-28-65 WATER WELL DRILLERS LOG

CODED

Date: 7-28, 1965, Driller: Chert Lewis County Amite
(Name)

(1) Owner of Land:	Description & Color of Materials Sand, Clay, Red Clay, Shell, etc.	Thick- ness Feet	Depth Feet
<u>Mrs. Edwin Martin</u> (Name) <u>R.F. Osyka</u> (Address)	<u>Red Clay</u>	<u>20</u>	<u>20</u>
	<u>Clay</u>	<u>80</u>	<u>100</u>
(2) Location: <u>1/4</u> , <u>1/4</u> , Sec. <u>28 T. 1 R. 6</u> <u>2</u> miles <u>East</u> of <u>Selby</u> (distance) (direction) (Nearest Town)	<u>Chalky sand</u>	<u>8</u>	<u>108</u>
	<u>Red sand</u>	<u>13</u>	<u>121</u>
(3) Topography: <u>Hilly</u> (Hilly) (Flat) (Level)			
(4) Purpose of Well: <u>Domestic</u> (Domestic Irrigation Municipal, Industrial, Other)			

CODED


Information upon completion of well:

- (1) Diameter 4 inches.
- (2) Total Depth 121 feet.
- (3) Water Level 75 feet below top of ground.
- (4) Cased to Bottom Size 4"
- (5) Screen: Size 4", Length 7'
- (6) Were any formations sealed against pollution?
_____ yes, no.

If YES depth of formation _____

Why _____

Drillers Remarks: dry well
Bad

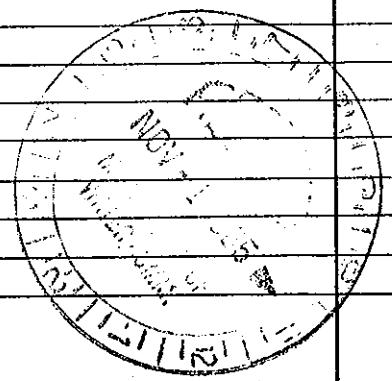

(Use Back Side)

Well No.

Mail this copy to Board of Water Commissioners 429 Miss. St. Jackson, Miss.