


Armita  
 U 43  
 9-15-75

MISSISSIPPI  
 BOARD OF WATER COMMISSIONERS  
 416 North State Street  
 Jackson, Mississippi 39201

WATER WELL DRILLERS LOG

9-15 1975 *F. J. ...* Armita  
 date well completed firm name county well located

LANDOWNER:	description of formations encountered	from	to
<i>Maria Wilson</i>			
<i>R.H. ...</i> (billing address)	<i>Red Clay</i>	<i>0</i>	<i>20</i>
	<i>Red Sand</i>	<i>20</i>	<i>135</i>
	<i>Coarse sand &amp; gravel</i>	<i>135</i>	<i>150</i>
<b>WELL LOCATION:</b>			
sec <i>21</i> T <i>10</i> N R <i>6</i> E			
<i>10</i> miles <i>W</i> of <i>... </i>			
(distance) (direction) (nearest town)			
<b>WELL PURPOSE:</b> (home, irrigation, municipal, industrial)			
<b>WELL COMPLETION DATA:</b>			
(1) diameter (inches) <i>4</i>			
(2) total depth (feet) <i>150</i>			
(3) static water level (feet) <i>75</i> below above top of ground.			
(4) casing <i>plastic</i> , <i>142</i> , (material) (depth)			
<i>4</i> (size) if telescope see back.			
(5) screen <i>8</i> , <i>142</i> (length) (depth to top)			
<i>4</i> , <i>plastic</i> (size) (material)			
(6) pump <i>1</i> , <i>18</i> (HP) (yield gpm)			
<i>abc</i> (type power)			
(7) electric log <i>no</i> (yes or no)			
(organization running log)			
(8) how well bottom plugged <i>level shut</i>			
<b>DRILLERS REMARKS:</b>			

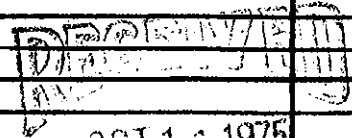

OCT 1 1975