


Amite  
 21 44  
 8-24-75

MISSISSIPPI  
 BOARD OF WATER COMMISSIONERS  
 416 North State Street  
 Jackson, Mississippi 39201

WATER WELL DRILLERS LOG

8-24 1975 Fitzgerald Well Serv Amite  
 date well completed firm name county well located

LANDOWNER:	description of formations encountered	from	to
Bill Moore			
R.R. Oyster (mailing address)	Red clay	0	20
	Red sand & gravel	20	145
	Coarse sand & gravel	145	160
<b>WELL LOCATION:</b>			
sec. <u>17</u> T. <u>10</u> N. R. <u>6</u> E			
<u>9</u> miles <u>W</u> of <u>Oyster</u> (distance) (direction) (nearest town)			
<b>WELL PURPOSE:</b> <u>Home</u> (home, irrigation, municipal, industrial)			
<b>WELL COMPLETION DATA:</b>			
(1) diameter (inches) <u>4</u>			
(2) total depth (feet) <u>160</u>			
(3) static water level (feet) <u>70</u> below above top of ground.			
(4) casing <u>plastic</u> , <u>152</u> , (material) (depth) <u>4</u> if telescope see back. (size)			
(5) screen <u>8</u> , <u>152</u> , (length) (depth to top) <u>4</u> , <u>plastic</u> (size) (material)			
(6) pump <u>3/4</u> , <u>16</u> , (HP) (yield gpm) <u>electric</u> (type power)			
(7) electric log <u>no</u> (yes or no) (organization running log)			
(8) how well bottom plugged <u>Seal block</u>			
<b>DRILLERS REMARKS:</b>			

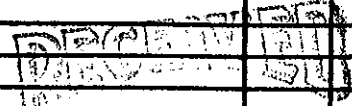

OCT 16 1975

MISS. BD. OF WATER COMM