

State Well Report

Part 1 - Driller's Log

Mississippi Department of Environmental Quality
Office of Land and Water Resources
P.O. Box 10631
Jackson, MS 39289-0631
(601)961-5210
(601)354-6938 (fax)

County: Amite
Permit #: _____
Driller: Fitzgerald Well Service
Date drilling completed: 11-3-06

For Office Use Only:
Aquifer: _____
Well #: U-88
L. S. Elevation: _____
E-log #: _____

State Law requires that this report be prepared by the license holder responsible for the work and filed with the Department at the above address within 30 days of completion of drilling of the well or borehole.

Information on Well Owner (Landowner if borehole is not for a water well)	Well or Borehole Location
Owner Name: <u>Glen Manceaux</u>	Latitude: _____ Longitude: _____
Mailing Address: <u>Hwy 584</u>	Method of Lat/Long (circle one): Conventional Survey, USGS quad, Hand-held GPS, Survey-grade GPS
<u>Osyka</u> <u>MS</u>	_____ 1/4 _____ 1/4 Sec <u>29</u> Twn <u>1N</u> Rng <u>6E</u>
City State Zip Code	Distance <u>8</u> Miles Direction <u>West</u> of Nearest Town <u>Osyka</u>
Telephone No. (_____) _____	
Well / Borehole Data	
Date drilling started: <u>11-3-06</u> Date drilling completed: <u>11-3-06</u> Hole depth: <u>103'</u> Hole diameter: <u>7"</u>	
Location of the source of any surface water used for drilling: _____	
Method of dosing and volume of Chlorine used in drilling and development: _____	
Logs run (circle all applicable): <u>No log run</u> Electric Gamma Ray Density Sonic Neutron Other: _____	
Name of organization running log(s): _____	
Purpose of borehole (check one): Water Well <input checked="" type="checkbox"/> Geotechnical/Geological Investigation _____ Ground Source Heat Pump _____	
Seismic Survey _____ Other (describe) _____	
<i>If drilling is not related to water well construction, skip the remainder of this block</i>	
Purpose of Well (check one): Home <input checked="" type="checkbox"/> Industrial _____ Public Supply _____ Irrigation _____ Fish Culture _____ Other: _____	
If a flowing well, method of flow regulation: Valve _____ Other (describe) _____	
Static Water Level: <u>59'</u> feet above or below (circle one) land surface Date measured: <u>11-3-06</u>	
Method of Measurement (circle one) <u>steel tape</u> electric tape air line other: _____	
Well depth: <u>103'</u> Well grouted to a depth of <u>10'</u> feet Type of grout (circle one): <u>Neat Cement</u> Bentonite Mix	
Casing length: <u>93'</u> feet Casing diameter: <u>4"</u> inches Type of casing: <u>PVC</u>	
Screen length: <u>10'</u> feet Screen diameter: <u>4"</u> inches Type of screen: <u>PVC</u>	
Screen slot size: <u>1012</u> inches Setting depth: From <u>93'</u> feet to <u>103'</u> feet	
Type of completion (circle all applicable): <u>Gravel packed</u> Underreamed Telescoped Open hole Natural Development	
Other (describe): _____	
Top of lap pipe or reduction in casing: _____ feet. <i>If telescoped or more than one screen, describe on next page</i>	

Form: OLWR-SWR-1A


RECEIVED
NOV 14 2006
BY: OLWR

U-88

The sketch below only required for water wells

If well tabercases, show depths on sketch

Ground Level \rightarrow

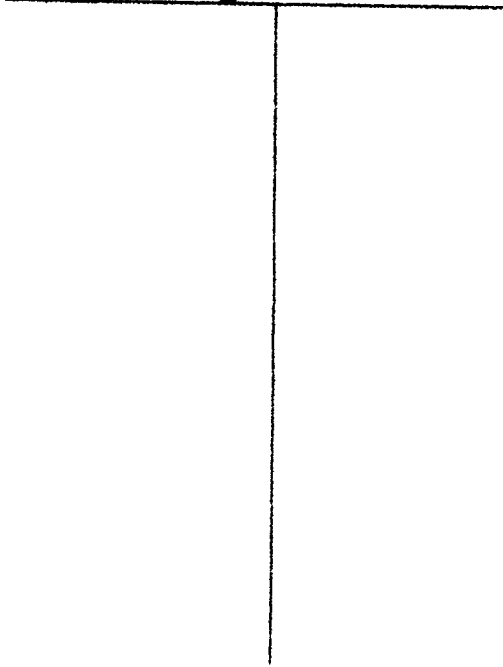

Description of formations encountered must be provided for all wells and boreholes, unless specifically exempted by regulations

Description of Formations Encountered	From (depth)	To (depth)
	Ground Level	
Clay	0	20
Sand	20	40
gravel	40	60
Clay	60	80
Sand	80	90
Coarse Sand	90	103

If more than one screen, show location of each on sketch

Sketch the property layout and include the following: 1) the well location; 2) any permanent structures on the property that may aid in locating the well; 3) any roads, power lines, or other items that may aid in locating the property and the well; 4) a north arrow.

Landowner Name: Glen Manceaux

Form: OLWR-SWR-1A

I certify that the well/borehole was drilled, constructed, and completed in accordance with all applicable requirements of the Mississippi Department of Environmental Quality and the Mississippi Department of Health regulations, if applicable, and state laws.

Brad Fitzgerald 029 11-3-06

Brad Fitzgerald

Print Name of Responsible Licensee and License No.

Date

Signature of Licensee

RECEIVED
NOV 14 2006
BY: OLWR

STATE WELL REPORT

Part 2

Pump Installer's Completion Report
 Mississippi Department of Environmental Quality
 Office of Land and Water Resources
 P.O. Box 10631
 Jackson, MS 39289-0631
 (601)961-5210
 (601)354-6938 (fax)

County: Amite
 Permit #: _____
 Driller: Fitzgerald Well Service
 Date completed: 11-3-06
Copy information from block on Part 1

For Office Use Only:

AQUIFER: _____
 Well #: U-88
 Elevation: _____

This part of the report must be completed by a licensed water well contractor or a licensed pump installer. A copy of Part 1 of the report must be attached and both parts filed with the Department at the above address within 30 days of well completion.

Well Owner Information	Well Location
Owner Name: <u>Glen Manceaux</u>	Latitude: _____ Longitude: _____
Mailing Address: <u>Hwy 584</u>	Method of Lat/Long (check one): <input type="checkbox"/> Conventional Survey _____
<u>Osyka MS</u>	USGS quad _____ Hand-held GPS _____ Survey-grade GPS _____
City: _____ State: _____ Zip Code: _____	_____ 1/4 _____ 1/4 Sec. <u>29</u> T. <u>1N</u> R. <u>6E</u>
Telephone No. (_____) _____	Distance _____ Direction _____ Nearest Town _____
	<u>8</u> Miles <u>West</u> of <u>Osyka</u>

Pump Type Circle one	Power type Circle one
Air Lift <input type="checkbox"/> Jet <input type="checkbox"/> <u>Submersible</u>	Diesel Engine <input type="checkbox"/> Gasoline Engine <input type="checkbox"/> Natural Gas <input type="checkbox"/>
Bucket <input type="checkbox"/> Piston <input type="checkbox"/> Turbine <input type="checkbox"/>	<u>Electric Motor</u> <input type="checkbox"/> Hand <input type="checkbox"/> Tractor PTO <input type="checkbox"/>
Centrifugal <input type="checkbox"/> Rotary <input type="checkbox"/> Flowing Well <input type="checkbox"/>	Windmill <input type="checkbox"/> Other (specify): _____
Other (specify): _____	Horse Power Rating of Motor: <u>1</u>
Date Pump Installed: <u>11-3-06</u>	Setting Depth: <u>90'</u> feet
Rated Pump Capacity: <u>20</u> Gallons Per Minute	Number of Stages: <u>8</u>

Pump Test Data	Method of Measuring Water Level Circle one
Date Well Tested: _____	Air Line <input type="checkbox"/> Electric Measuring Line <input checked="" type="checkbox"/> <u>Steel Tape</u>
Static Water Level (A): _____ Feet Below Land Surface	Other (specify): _____
Pumping Water Level (B): _____ Feet Below Land Surface	For flowing well, measured shut in head: _____ feet
Drawdown [(B) - (A)]: _____ Feet Below Land Surface	Well yielded _____ GPM with a drawdown of _____
Test Pumping Rate: _____ Gallons Per Minute	_____ feet after _____ hours of pumping
Duration of Pump Test (minimum 4 hours): _____ hours	

I HEREBY CERTIFY that the above statements are true to the best of my knowledge.

Brad Fitzgerald 029
 Print Name of Pump Installer and License No. (if applicable)

Brad Fitzgerald
 Signature of Pump Installer

Form OLWR-SWR-18

RECEIVED

NOV 14 2006

BY: OLWR