

Part 2 never received 3/2013

County: Amite
 Permit #: N/A
 Driller: Justin Robinson
 Date drilling completed: 5/18/10

State Well Report
Part 1 - Driller's Log

Mississippi Department of Environmental Quality
 Office of Land and Water Resources
 P.O. Box 2309
 Jackson, MS 39225
 (601)961-5210
 (601)961-5228 (fax)

For Office Use Only:
 Aquifer: V 108
 Well #: _____
 L. S. Elevation: _____
 E-log #: _____

State Law requires that this report be prepared by the license holder responsible for the work and filed with the Department at the above address within 30 days of completion of drilling of the well or borehole.

<p>Information on Well Owner (Landowner if borehole is not for a water well)</p> <p>Owner Name: <u>Justin Ross Robinson</u> Mailing Address: <u>1546 McMillian rd</u> <u>Osyka Ms 39057</u> City State Zip Code Telephone No. (601) <u>248 3412</u></p>	<p>Well or Borehole Location</p> <p>Latitude: <u>N 31° 02' 14.5"</u> Longitude: <u>W 90° 30' 16.9"</u> 41 Method of Lat/Long (circle one): Conventional Survey, USGS quad: <u>Hand-held GPS</u> Survey-grade GPS <u>NW 1/4 SW 1/4 Sec 21 Twn 1 N Rng 6 E</u> Distance _____ Direction _____ Nearest Town _____ _____ Miles _____ of _____</p>
---	--

Well / Borehole Data

Date drilling started: 5/18/10 Date drilling completed: 5/18/10 Hole depth: 120 Hole diameter: 7 7/8

Location of the source of any surface water used for drilling: none
 Method of dosing and volume of Chlorine used in drilling and development: 2ppm chlorine backwash

Logs run (circle all applicable): (No log run) Electric Gamma Ray Density Sonic Neutron Other: _____
 Name of organization running log(s): _____

Purpose of borehole (check one): Water Well Geotechnical/Geological Investigation _____ Ground Source Heat Pump _____
 Seismic Survey _____ Other (describe) _____

If drilling is not related to water well construction, skip the remainder of this block

Purpose of Well (check one): Home Industrial _____ Public Supply _____ Irrigation _____ Fish Culture _____ Other: _____

If a flowing well, method of flow regulation: Valve _____ Other (describe) none

Static Water Level: 84 feet above or below (circle one) land surface Date measured: 5/18/10

Method of Measurement (circle one) steel tape electric tape air line other: _____

Well depth: 120 Well grouted to a depth of 10 feet Type of grout (circle one): Neat Cement Bentonite (Mix)

Casing length: 100 feet Casing diameter: 4 inches Type of casing: pvc 4" sch 40

Screen length: 20 feet Screen diameter: 4 inches Type of screen: pvc slotted

Screen slot size: 0.10 inches Setting depth: From 100 feet to 120 feet

Type of completion (circle all applicable): Gravel packed Underreamed Telescoped Open hole Natural Development
 Other (describe): _____

Top of lap pipe or reduction in casing: _____ feet. *If telescoped or more than one screen, describe on next page*

Form: OLWR-SWR-1A (04/08)

RECEIVED

MAY 18 2010


BY: OLWR

4108

The sketch below only required for water wells

If well telescopes, show depths on sketch.

Ground Level \swarrow

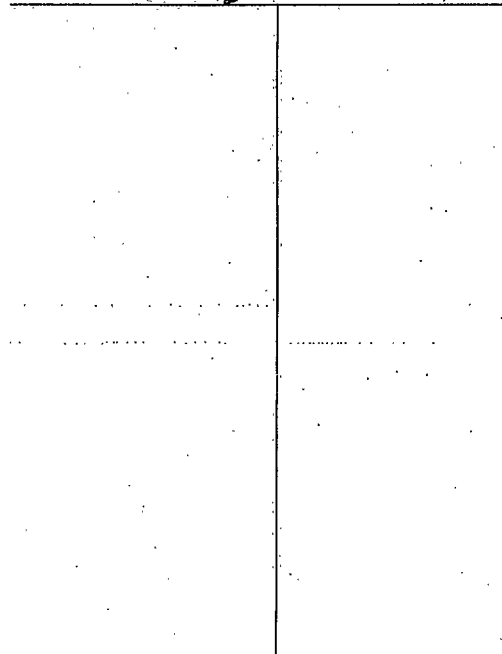

Description of formations encountered must be provided for all wells and boreholes, unless specifically exempted by regulations

Description of Formations Encountered	From (depth)	To (depth)
\odot Top soil	Ground Level	2
red clay with coarse sand	2	45
coarse sand	45	82
coarse white sands	82	120

If more than one screen, show location of each on sketch

Sketch the property layout and include the following: 1) the well location; 2) any permanent structures on the property that may aid in locating the well; 3) any roads, power lines, or other items that may aid in locating the property and the well; 4) a north arrow.

Landowner Name: Justin Robinson

Form: OLWR-SWR-1A (04/08)

I certify that the well/borehole was drilled, constructed, and completed in accordance with all applicable requirements of the Mississippi Department of Environmental Quality and the Mississippi Department of Health regulations, if applicable, and state laws.

Joseph W Juneau 0516 5/8/10
Print Name of Responsible Licensee and License No. Date

Signature of Licensee

License Applied for
Justin Robinson

RECEIVED
MAY 18 2010
BY: OLWR