| State V | Vell Report | | | |
|------------------------------------------------------------------------------------------------------------------------------------|---------------------------------------------------------------------------------------------------------------------|----------------------------------------|--|--|
| County Amte Part 1- | Driller's Log | For Office Use Only: | | |
| Mississippi Departme | ent of Environmental Quality and Water Resources | Aquifer: 0 118 | | |
| P.O. P.O. | . Box 2309 | Well #: | | |
| | on, MS 39225)961- 5210 | L. S. Elcvation: | | |
| Date drilling completed: (601)9 | 51- 5228 (fax) | E-log #: | | |
| State Law requires that this report be prepared by the li | cense holder responsible for | the work and filed with the | | |
| Department at the above address within 30 days of completion of drilling of the well or borehole. | | | | |
| (Landowner if borehole is not for a water well) | aformation on Well Owner er if borehole is not for a water well) Latitude: 31° 4', 44" Longitude: 90° 35' 15. | | | |
| Owner Name Gren Ensloy | Latitude: <u>51 ° 4 , 44</u> | " Longitude: <u>40, 35, 15</u> " | | |
| Mailing Address: EASkyld | Method of Lat/Long (circle or | ne): Conventional Survey, | | |
| Mailing Address: | USGS quad, Hand-held | | | |
| | NW1/56 1/ Sec_ 3 | | | |
| City State Zip Code | Menut My | | | |
| • | Milesof | | | |
| Telephone No. () | | | | |
| | ehole Data | ······································ | | |
| Date drilling started: 11-21-11 Date drilling completed: 11-21-11 Hole depth: 83 Hole diameter: 811 | | | | |
| Location of the source of any surface water used for drilling: Method of dosing and volume of Chlorine used in drilling and dev | elopment: | | | |
| Logs run (circle all applicable): No log run Electric Gamma Ray Density Sonic Neutron Other: | | | | |
| Purpose of borehole (check one): Water WellGeotechnical/Geo | logical Investigation Ground | Source Heat Pump | | |
| Seismic SurveyOther (describ | e) | | | |
| | | | | |
| Purpose of Well (check one): Home Lindustrial Public Supply Irrigation Fish Culture Other: | | | | |
| If a flowing well, method of flow regulation: Valve Other (describe) | | | | |
| Static Water Level:feet above or below (circle one) land surface Date measured: | | | | |
| Method of Measurement (circle one) steel tap electric tape air line other: | | | | |
| Well depth: <u>P3</u> Well grouted to a depth of <u>10</u> feet Type of grout (circle one) Neat Cement Bentonite Mix | | | | |
| Casing length: 73 feet Casing diameter: 4" inches Type of casing: puc | | | | |
| Screen length: <u>10</u> feet Screen diameter: <u>9</u> inches Type of screen: <u>10</u> | | | | |
| Screen slot size: <u>012</u> inches Setting depth: From <u>73</u> feet to <u>33</u> feet | | | | |
| Type of completion (circle all applicable): Gravel packed Underreamed Telescoped Open hole Natural Development | | | | |
| Other (describe): | | | | |
| Top of lap pipe or reduction in casing:feet. If telescoped or more than one screen, describe on next page | | | | |
| | | Form: OLWR-SWR-1A (04/08) | | |

• • • • •

.

DEC 0 8 2011 BY: OLWR

U118


The sketch below only required for water wells

| If well telescopes, show depths on s | sketch. |
|--------------------------------------|---------|
| Ground Level | |

Description of formations encountered must be provided for all wells and boreholes, unless specifically exempted by regulations

| Description of Formations Encountered | From (depth) | To (depth) |
|---------------------------------------|--------------|------------|
| | Ground Level | |
| clur | 0 | 20 |
| Sandi | 20 | 10 |
| Sand | 40 | 60 |
| Sandi Sandi Couse Sand | 60 | 83 |
| | | |
| | | |
If more than one screen, show location of each on sketch

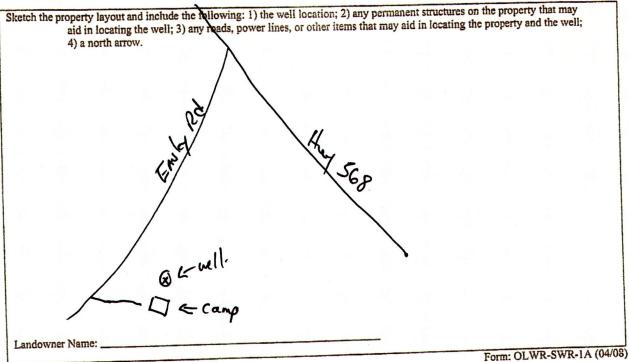

I certify that the well/borehole was drilled, constructed, and completed in accordance with all applicable requirements of the Mississippi Department of Environmental Quality and the Mississippi Department of Health regulations, if applicable, and state

laws. 11-21-11 BIAS Elzerald 074, Date

Print Name of Responsible Licensee and License No.

Signature of Licensee



| | | | DEC 0 8 2011 |
|------------------------------------------------------------------------------------------------------------------------------------------------------|-------------------------------------------------------|--------------------------------------------------|---------------|
| Print Name of Pulity Instance and Endense No. (2 off | | FUIL OLWA-OWA-IC | REPENSED |
| I HEREBY CERTIFY that the above statements are true to the best Bind Figeral OF9. Print Name of Pump Installer and License No. (if applicable) | t of my knowledge | np Installer Form: OLWR-SWR-10 | (07-09) AFAAF |
| This is for (circle one): New Well Replacement of E | | of Existing Pump | |
| Duration of Pump Test (minimum 4 hours):hours | | | |
| Test Pumping Rate: Gallons Per Minute | | GPM with a drawdown of | |
| Drawdown [(B) - (A)]:Feet Below Land Surface | | d shut in head:fe | |
| Static Water Level (A):Feet Below Land Surface Pumping Water Level (B):Feet Below Land Surface | Other (specify): | | - |
| Pump Test Data Date Well Tested: | | Circle one feasuring Line Steel Tape | > |
| Rated Pump Capacity:Gallons Per Minute | | Measuring Water Level | |
| Date Pump Installed: | Setting Depth: | | |
| Other (specify): | Horse Power Rating of Mot | or: 1/2 | - |
| Bucket Piston Turbine | Electric Motor Hand Windmill Othe | r (specify): | |
| Air Lift Jet Subactsible | Diesel Engine Gaso | line Engine Natural Ga | |
| Ритр Туре | | ower Type Circle one | |
| Telephone No. () | Distance Direction Miles | of | |
| City State Zip Code | | <u>3</u> T <u>IN</u> R <u>GE</u> Nearest Town | |
| | USGS quad, Hand-hel | d GPS, Survey-grade GPS | |
| Dwner Name: Greg EAsky. Mailing Address: EAsky Rd, | | _ Longitude: <u>10 33 1</u> | |
| report must be attached and both parts filed with the Department at Well Owner Information | We above lady cas within 50 | IL Location Longitude: 90° 35′ 15 | |
| Copy internation from output on the state of the state of water well of | ontractor or a licensed Dumb | installer. A copy of Part I of the | 2 |
| Date completed: (601)9 | MS 39225)61-5210 -5228 (fax) | Elevation: | - |
| Driller: Fitzgerald well Sure Office of Land an P.O. B | ad Water Resources | Well #: | |
| Pump Installer's | rt 2 Completion Report of Environmental Quality | Aquifer. | |
| STATE WE | _ | For Office Use Only: | |

- -

-1