


AMITE  
 U 2016  
 6-13-80  
 June 13 1980  
 date well completed

MISSISSIPPI  
 BOARD OF WATER COMMISSIONERS  
 416 North State Street  
 Jackson, Mississippi 39201

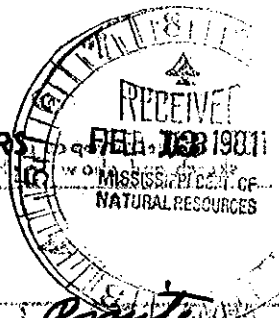

WATER WELL DRILLERS LOG

SO Reeves Well Inc  
 firm name  
 Amite  
 county well located

LANDOWNER:  
 Sam Cutner  
 (mailing address)

WELL LOCATION:  
 sec. 14 T 1 N R 6 E  
 5 miles ESE of Gileburg  
 (distance) (direction) (nearest town)

WELL PURPOSE:  
 (home, irrigation, municipal, industrial)

WELL COMPLETION DATA:  
 (1) diameter (inches) 4"  
 (2) total depth (feet) 122  
 (3) static water level (feet) 70 below top of ground  
 (4) casing Plastic ballon  
 (material) (depth)  
 (size) If telescope see back.  
 (5) screen 5' 117'  
 (length) (depth to top)  
 4" plastic  
 (size) (material)  
 (6) pump gear drive  
 (HP) (yield gpm)  
slit  
 (type power)  
 (7) electric log no  
 (yes or no)  
 (organization running log)

(8) how well bottom plugged  
backwash valve  
 DRILLERS REMARKS:

description of formations encountered	from	to
Red Clay	0	24
Red sand	24	610
sand & small gravel	62	95
Chalk (bed)	95	108
Coarse sand & gravel	108	122

