

ATTALA MISSISSIPPI BOARD OF WATER COMMISSIONERS

A 2000

A-300

WATER WELL DRILLERS LOG

8-31-60

Date: 8-31, 1960, Driller: Smith & Preeley, County, ATTALA

(1) Owner of Land: A. J. J. Goss
 (Name)
Vaiden miss R-2
N 1/2 W 2 Sec 10 R 12 W 8 N 1/4

(2) Location: 1/4, 1/4, Sec. 13 T16R6
NE
14 miles N. H. W. Y 35 of Kosciusko
 (distance) (direction) (Nearest Town)

(3) Topography: Hilly
 (Hilly) (Flat) (Level)

(4) Purpose of Well: Domestic
 (Domestic Irrigation
 Municipal, Industrial, Other)

Description Sand, Clay	Materials Cement, Well, etc	Thick- ness Feet	Dep- th Feet
Red sand		10	10
yellow sand		30	40
Hard spot to or three inches			
gray sand mix with black		23	63
blue clay		5	68
blue Rock about		6"	68
1/2" inches			
back to blue			
Clay		3 1/2	72
hard Red Shale		4	76
Coarse blue			
sand mixed with			
blue clay		10	86
blue shale		8	94
White Coarse sand		19	113

Information upon completion of well:

(1) Diameter 2 X 1/4 inches.

(2) Total Depth 110 feet.

(3) Water Level 13 feet below top of ground.

(4) Cased to 97, Size 2"


(5) Screen: Size 1/2 X 6", Length 6"

(6) Were any formations sealed against pollution?
 _____ yes, X no.

If YES depth of formation _____

Why _____

Drillers Remarks: _____

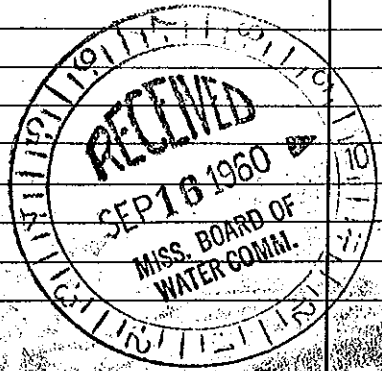

(Use Back Side)

Mail this copy to Board of Water Commissioners 429 Miss. St. T-