

ATTALA MISSISSIPPI BOARD OF WATER COMMISSIONERS

A 2002
9-15-65

WATER WELL DRILLERS LOG

Date: 9-15, 1965, Driller: Thomast Son County Attala
(Name)

		Description & Color of Materials Sand, Clay, Red Clay, Shell, etc.	Thick- ness Feet	Depth Feet
(1) Owner of Land: <u>Mr. Norwood</u> (Name)		<u>Red Clay</u>	<u>15</u>	<u>0</u>
<u>West, Miss.</u> (Address)		<u>BLACK DIRT</u>	<u>50</u>	<u>15</u>
(2) Location: <u>SE 1/4, SE 1/4, Sec 25 T16R5</u>		<u>Greenish Sand</u>	<u>43</u>	<u>65</u>
<u>3 1/2</u> miles <u>E</u> of <u>West, Miss.</u> (distance) (direction) (Nearest Town)		<u>w/ streaks of</u>		
(3) Topography: <u>ON Hill</u> (Hilly) (Flat) (Level)		<u>CHALK</u>		
(4) Purpose of Well: <u>Domestic</u> Irrigation Municipal, Industrial, Other				


Information upon completion of well:

- (1) Diameter 2 inches.
 (2) Total Depth 108 feet.
 (3) Water Level 30 feet below top of ground.
 (4) Cased to 84 ft, Size 2"
 (5) Screen: Size _____, Length _____
 (6) Were any formations sealed against pollution?
 _____ yes, X no.

If YES depth of formation _____

Why _____

Drillers Remarks: _____

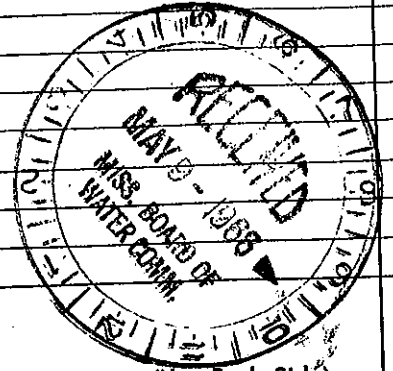

Mail this copy to Board of Water Commissioners 429 Miss. St. Jack