

ATTALA MISSISSIPPI BOARD OF WATER COMMISSIONERS

A 2003

7-8-66

WATER WELL DRILLERS LOG

Date: 7-8-66, 1966, Driller: Smith & Sons Attala county
(Name)

(1) Owner of Land:	Description & Color of Materials Sand, Clay, Red Clay, Shell, etc.	Thick- ness Feet	Depth Feet
<u>D. Edward Bayley</u> (Name)	<u>red clay</u>	<u>14</u>	<u>14</u>
<u>R2 West Miss</u> (Address)	<u>sand roots</u>	<u>18"</u>	<u>15</u>
(2) Location: <u>Px. W 2 1/4, NW 1/4, Sec. 25 T16R6</u>	<u>red sand</u>		
<u>12</u> miles <u>N</u> , of <u>Kosciusko</u> (distance) (direction) (Nearest Town)	<u>clay mixture</u>	<u>30</u>	<u>45</u>
(3) Topography: <u>Hilly</u> (Hilly) (Flat) (Level)	<u>yellow sand</u>	<u>30</u>	<u>65</u>
(4) Purpose of Well: <u>domestic</u> (Domestic Irrigation Municipal, Industrial, Other)	<u>hard slab</u> <u>white water</u> <u>sand</u>	<u>10</u>	<u>75</u>


Information upon completion of well:

- (1) Diameter 2 inches.
- (2) Total Depth 75 feet.
- (3) Water Level 38 feet below top of ground.
- (4) Cased to 69, Size 2
- (5) Screen: Size 1 1/4, Length 6"
- (6) Were any formations sealed against pollution?
_____ yes, no.

If YES depth of formation _____

Why _____

Drillers Remarks: _____

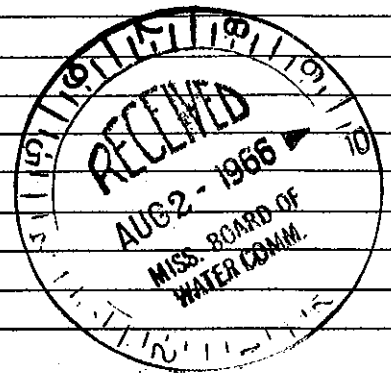

16

Well No.

(Use Back Side)

Mail this copy to Board of Water Commissioners 429 Miss. St. Jackson