

ATTALA
A 2005
3-68

MISSISSIPPI
BOARD OF WATER COMMISSIONERS
416 North State Street
Jackson, Mississippi 39201

WATER WELL DRILLERS LOG

3-29 1968 Thomas & Son ATTALA
date well completed firm name county well located


LANDOWNER: Milburn Chandler
Hwy 35 North
Kosciusko, Miss.
(mailing address)

WELL LOCATION:
sec 26 T 16 N R 6 E
S W
11 miles N of Kosciusko
(distance) (direction) (nearest town)

WELL PURPOSE:
(Home Irrigation, municipal, industrial)

WELL COMPLETION DATA:
(1) diameter (inches) 2
(2) total depth (feet) 168
(3) static water level (feet) 145 ^{below} top of ground.
(4) casing P.V.C. pipe 105'
(material) (depth)
2"
(size) if telescope see back.
(5) screen None
(length) (depth to top)
(size) (material)
(6) pump 1/2 5
(HP) (yield gpm)
Elec
(type power)
(7) electric log NO
(yes or no)
(organization running log)
(8) how well bottom plugged

description of formations encountered	from
Sandy DIRT	0
SANDY ROCK	20
Red SAND	21
Course SAND	43
Chalk & SAND	55
Course Red SAND	65
W Little Chalk str.	
Hard Black DIRT	98
& Slate Rock	
Course Grey Green SAND	110
Slate Rock	132
Streaks Rock & SAND	138

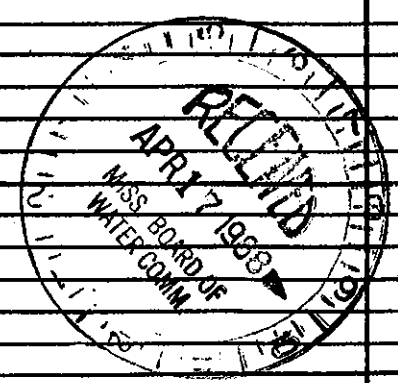

DRILLERS REMARKS: