


ATTALA MISSISSIPPI BOARD OF WATER COMMISSIONERS

B 2002
6-14-66

WATER WELL DRILLERS LOG

Date: 6-14, 1966, Driller: THOMAS & SON County ATTALA
(Name)

	Description & Color of Materials Sand, Clay, Red Clay, Shell, etc.	Thick- ness Feet	Depth Feet
(1) Owner of Land: <u>Mr. R. L. TAsper</u> (Name) <u>Kosciusko, Miss.</u> (Address)	<u>CLAY</u>	<u>25</u>	<u>0</u>
(2) Location: <u>NW 1/4, SW 1/4, Sec 25 T16 R7</u> <u>12</u> miles <u>N</u> , of <u>Kosciusko</u> (distance) (direction) (Nearest Town)	<u>DRY SAND</u> <u>SAND w/ CHALK</u> <u>DRY SAND</u> <u>Coarse White Sand</u>	<u>17</u> <u>18</u> <u>15</u> <u>15</u>	<u>25</u> <u>42</u> <u>60</u> <u>75</u>
(3) Topography: <u>(Hilly)</u> (Flat) (Level)			
(4) Purpose of Well: <u>(Domestic)</u> Irrigation Municipal, Industrial, Other)			
Information upon completion of well:			
(1) Diameter <u>2</u> inches.			
(2) Total Depth <u>90</u> feet.			
(3) Water Level <u>75</u> feet below top of ground.			
(4) Cased to <u>84</u> , Size <u>2"</u>			
(5) Screen: Size <u>60 G.</u> , Length <u>6 Ft.</u>			
(6) Were any formations sealed against pollution? _____ yes, <u>✓</u> no.			
If YES depth of formation _____			
Why _____			
Drillers Remarks: _____			

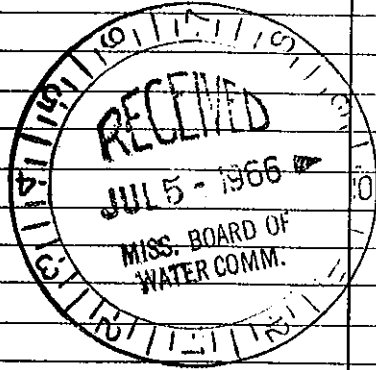

Retain this copy for your office files.

(Use Back Side)

Well No.