

MISSISSIPPI DEPARTMENT OF NATURAL RESOURCES

Bureau of Land and Water Resources

P.O. Box 10631

Jackson, Mississippi 39209

WATER WELL DRILLERS LOG

287

COUNTY WELL LOCATED <i>Attala</i>	
WELL NUMBER <i>C 2011</i>	CODED
DATE WELL COMPLETED: <i>May 10, 1999</i>	

PERMIT NUMBER
NAME OF DRILLING FIRM <i>Thomas Drilling Carthage, MS</i>

NAME & MAILING ADDRESS OF LANDOWNER <i>J. Palma tree Berea Church Road McCool, MS</i>		
WELL LOCATION: SEC	TOWNSHIP	RANGE
<i>24</i>	<i>16</i>	<i>8</i>
	N S	E W
DISTANCE <i>5</i> Miles	DIRECTION <i>NW</i>	NEAREST TOWN <i>McCool</i>
OTHER LANDMARK <i>1/2 mile SE of Church</i>		
WELL PURPOSE: Home, Irrigation, Municipal, Industrial, Fish Pond, etc. <i>Home</i>		

PUMP DATA		
PUMP TYPE (Circle One): Submersible, Turbine, <input checked="" type="radio"/> Jet, Flowing Well, Other (Describe) <i>1-H.P.</i>		
POWER TYPE (Circle One): <input checked="" type="radio"/> Electric, Tractor, Diesel, Gasoline, Butane, Other (Describe) <i>H/P</i>		
Pump Capacity (GPM) <i>8</i>	No. of Stages <i>2</i>	Setting Depth <i>60'</i> FT.
PUMP TEST		
Well yielded <i>8</i> GPM with a drawdown of <i>3</i> ft. after <i>1</i> hours of pumping		

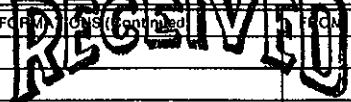
WELL DATA		
Well Depth <i>110</i>	Casing Diameter (In.) <i>2</i>	Casing Length (Ft.) <i>100'</i>
Type of Casing <i>PVC</i>	Hole Depth <i>110</i>	Depth to Static Water Level <i>42'</i>
TYPE OF COMPLETION: (Circle One or More): <input checked="" type="checkbox"/> Gravel Packed, <input type="checkbox"/> Underreamed, <input type="checkbox"/> Telescoped, <input type="checkbox"/> Natural Development, <input type="checkbox"/> Open Hole, <input type="checkbox"/> Other		
Top of Lap Pipe or Reduction in Casing <i>—</i> FEET		
IF TELESCOPED OR MORE THAN ONE SCREEN: USE BACK PAGE		

LOG DATA	
TYPE OF LOG RUN (Circle One): <input checked="" type="radio"/> No Log Run, Electric, Gamma Ray, Density, Sonic, Neutron, Other (Describe)	
Name of Organization Running Log	

SCREEN DATA		
Diameter - Inches <i>2</i>	Length - Feet <i>10</i>	Slot Size - Inches <i>.10</i>
Screen Type <i>PVC wrapped</i>	Depth to Bottom - Feet <i>110'</i>	

GEOLOGIC DATA (Office Use Only)			
Surface Elev.	Geologic Unit	Unit Thickness	Depth to Top
Subs. SWL	Date	Analysis	Aquifer Test
Driller's Remarks			

DESCRIPTION OF FORMATIONS ENCOUNTERED	FROM	TO
<i>Brown Dirt</i>	<i>0</i>	<i>2</i>
<i>Red & Yellow Chalk</i>	<i>2</i>	<i>15</i>
<i>Yellow Sand</i>	<i>15</i>	<i>60</i>
<i>White Sand</i>	<i>60</i>	<i>110</i>

FORMATIONS (continued)		FROM	TO
 JUN 27 1989			
Department of Natural Resources Bureau of Land & Water Resources			