

ATTALA MISSISSIPPI BOARD OF WATER COMMISSIONERS

D 13

**CODED**

10-23-61

WATER WELL DRILLERS LOG

ATTALA

Date: 10/23/, 1961, Driller: L. K. Merritt County Choctaw

(Name)

		Description & Color of Materials Sand, Clay, Red Clay, Shell, etc.	Thick- ness Feet	Depth Feet
(1) Owner of Land: <u>Guy C. Bennett</u> (Name) <u>McCool Miss</u> (Address)		<u>Surge clay</u>	<u>0</u>	<u>20</u>
		<u>Light grey clay</u>	<u>30</u>	<u>36</u>
		<u>Hard light grey</u>	<u>36</u>	<u>37</u>
(2) Location: <u>1/4</u> , <u>1/4</u> , Sec. <u>36</u> T. <u>16</u> R. <u>9</u>		<u>Hard blue clay</u>	<u>37</u>	<u>112</u>
<u>1/2</u> miles <u>South</u> of <u>McCool</u> (distance) (direction) (Nearest Town)		<u>Light blue clay, trace</u>		
		<u>to blue sandstone</u>	<u>112</u>	<u>117</u>
(3) Topography: <input checked="" type="checkbox"/> (Hilly) <input type="checkbox"/> (Flat) <input type="checkbox"/> (Level)		<u>Med. Hard blue clay</u>	<u>117</u>	<u>122</u>
(4) Purpose of Well: <u>Domestic</u> (Domestic Irrigation, Municipal, Industrial, Other)		<u>Fine blue sand</u>	<u>122</u>	<u>188</u>
		<u>trace of shale</u>		


Information upon completion of well:

- (1) Diameter 2 inches.
- (2) Total Depth 188 feet.
- (3) Water Level 40' feet below top of ground.
- (4) Cased to 105, Size 2
- (5) Screen: Size open, Length \_\_\_\_\_
- (6) Were any formations sealed against pollution?  
 yes,  no.

If YES depth of formation to shale top at 105'

Why to prevent hole from  
Drillers Remarks filling below open  
Casing.

**CODED**

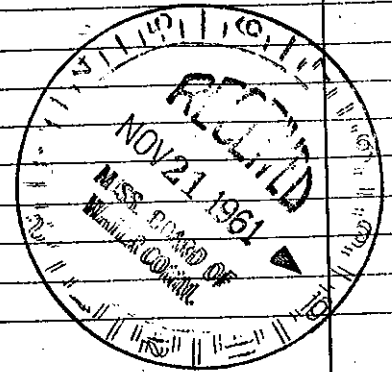

(Use Back Side)

Mail this copy to Board of Water Commissioners 429 Miss. St. Jackson, Miss.

Well No.