

ATTALA

MISSISSIPPI BOARD OF WATER COMMISSIONERS

D 15

WATER WELL DRILLERS LOG

CODED

12-20-60

Date: 12-20, 1960, Driller: *Beaswell Drilling Co* County *Ottala*

Licenses #0093 (Name)

(1) Owner of Land: *McCool School*
(Name)
McCool, Miss
(Address)

(2) Location: $\frac{1}{4}$, $\frac{1}{4}$, Sec. *35 16 R 9*
(distance) miles (direction) of (Nearest Town)

(3) Topography: *Hilly*
(Hilly) (Flat) (Level)

(4) Purpose of Well: *School water*
(Domestic Irrigation Municipal, Industrial, Other)

Description & Color of Materials Sand, Clay, Red Clay, Shell, etc.	Thick-ness Feet	Depth Feet
<i>First 21' white Chalk</i>	<i>21</i>	<i>21</i>
<i>Black shale</i>	<i>339</i>	<i>360</i>
<i>White silt to</i>	<i>102</i>	<i>462</i>

Information upon completion of well:

(1) Diameter *2* inches.


(2) Total Depth *462* feet.

(3) Water Level *40* feet below top of ground.

(4) Cased to *315*, Size *2"*

(5) Screen: Size *perforated pipe to bottom 1 1/4"*

(6) Were any formations sealed against pollution?
 _____ yes, _____ no.

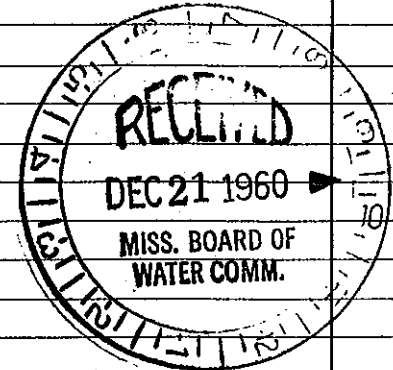

CODED

If YES depth of formation _____

Why _____

Drillers Remarks: *Should be good water*

(Use Back Side)

Mail this copy to Board of Water Commissioners 429 Miss. St. Jackson, N

Well