

ATTALA MISSISSIPPI BOARD OF WATER COMMISSIONERS

D 2000  
1-17-62


WATER WELL DRILLERS LOG

P-300  
D-300

Date: 1-17, 1962, Driller: Smith & Presley County Attala

(Name)

(1) Owner of Land: <u>Joyce McKnight</u> (Name)	Description & Color of Materials Sand, Clay, Red Clay, Shell, etc.	Thick- ness Feet	Depth Feet
<u>McCool Miss R. 3</u> (Address)	<u>Red sand</u>	13	13
(2) Location: <u>SE 1/4, NE 1/4, Sec. 34 T16 R2E,</u>	<u>three or four in</u>		
<u>2</u> miles <u>East/W</u> , of <u>McCool</u> (distance) (direction) (Nearest Town)	<u>sand rock</u>		
(3) Topography: <u>Hilly</u> (Hilly) (Flat) (Level)	<u>yellow clay</u>	16	29
(4) Purpose of Well: <u>Domestic</u> (Domestic Irrigation Municipal, Industrial, Other)	<u>blue clay</u>	18	47
Information upon completion of well:	<u>streak of black</u>		
(1) Diameter: <u>2"</u> inches.	<u>clay</u>	2	49
(2) Total Depth: <u>175</u> feet.	<u>light blue</u>	60	109
(3) Water Level: <u>60</u> feet below top of ground.	<u>clay</u>		
(4) Cased to: <u>147</u> , Size: <u>2"</u>	<u>gray silt sand</u>	14	123
(5) Screen: Size: <u>1/4</u> , Length: <u>12</u>	<u>white clay mixture</u>	14	123
(6) Were any formations sealed against pollution? _____ yes, _____ no.	<u>gray fine sand</u>	19	142
If YES depth of formation _____	<u>2 feet grade</u>	19	161
Why _____	<u>a coarse sand</u>	14	175
Drillers Remarks: _____			
<u>We will do better</u>			
<u>on our reports</u>			
<u>in the future</u>			

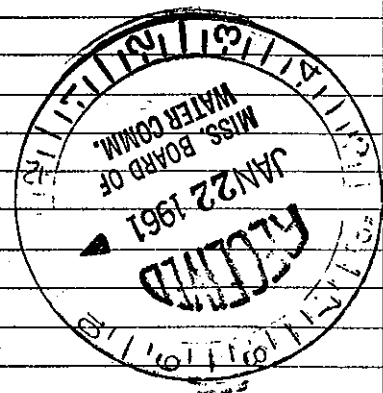

(Use Back Side)

Mail this copy to Board of Water Commissioners 429 Miss. St. Jackson, Miss

14  
#116