

ATTALA MISSISSIPPI BOARD OF WATER COMMISSIONERS


E6
6-64

WATER WELL DRILLERS LOG

CODED

Date: June, 1964, Driller: Jack Martin County Holmes
(Name)

		Description & Color of Materials Sand, Clay, Red Clay, Shell, etc.	Thick- ness Feet	Depth Feet
(1) Owner of Land: <u>Denton Edwards</u> (Name) <u>West</u> (Address)		<u>Clay</u>	<u>10</u>	<u>10</u>
(2) Location: <u>1/4</u> , <u>1/4</u> , Sec. <u>11</u> <u>15</u> <u>R</u> <u>5</u> <u>1 1/2</u> miles <u>SE</u> of <u>West</u> (distance) (direction) (Nearest Town)		<u>Soft rock</u>	<u>4</u>	<u>14</u>
(3) Topography: <u>Hilly</u> (Hilly) (Flat) (Level)		<u>Pipe clay - sand</u>	<u>7</u>	<u>21</u>
(4) Purpose of Well: <u>Domestic</u> (Domestic Irrigation Municipal, Industrial, Other)		<u>Black Mud</u> <u>6" rock at 75'</u>	<u>54</u>	<u>75</u>
		<u>Black Mud</u>	<u>9</u>	<u>84</u>
		<u>Mud - sand - shale</u>	<u>34</u>	<u>118</u>
		<u>Mud - sand</u>	<u>37</u>	<u>155</u>
		<u>Fine sand</u>	<u>30</u>	<u>185</u>
		<u>Mud</u>	<u>10</u>	<u>195</u>
		<u>Sand</u>	<u>10</u>	<u>205</u>
		<u>Mud & sand</u>	<u>5</u>	<u>210</u>
		<u>Sand</u>	<u>21</u>	<u>231</u>
Information upon completion of well:				
(1) Diameter <u>2</u> inches.				
(2) Total Depth <u>231</u> feet.				
(3) Water Level <u>38</u> feet below top of ground.				
(4) Cased to <u>221</u> , Size <u>2</u>				
(5) Screen: Size <u>2</u> , Length <u>10</u>				
(6) Were any formations sealed against pollution? _____ yes, _____ no.				
If YES depth of formation _____				
Why _____				
Drillers Remarks: _____				

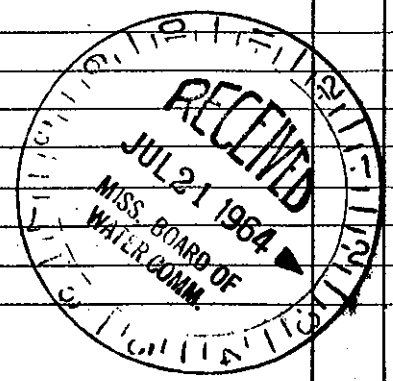

(Use Back Side)

Well No.

Mail this copy to Board of Water Commissioners 429 Miss. St. Jackson, Miss