

ATTALA
E 7
2-64

MISSISSIPPI BOARD OF WATER COMMISSIONERS

WATER WELL DRILLERS LOG

CODED

Date: Feb, 1964, Driller: Jack Martin County Holmes
(Name)

(1) Owner of Land: <u>Mrs. W. Ratliff</u> (Name) <u>West</u> (Address)	Description & Color of Materials Sand, Clay, Red Clay, Shell, etc.	Thick- ness Feet	Depth Feet
	<u>Clay</u>	<u>23</u>	<u>23</u>
(2) Location: <u>1/4</u> , <u>1/4</u> , Sec. <u>12 15 R 5</u> <u>2</u> miles <u>East</u> of <u>West</u> (distance) (direction) (Nearest Town)	<u>Sand & Mud</u>	<u>42</u>	<u>65</u>
	<u>Sand</u>	<u>16</u>	<u>81</u>
(3) Topography: <u>Hilly</u> (Hilly) (Flat) (Level)			
(4) Purpose of Well: <u>Domestic</u> (Domestic Irrigation Municipal, Industrial, Other)			

Information upon completion of well:


- (1) Diameter 2 inches.
- (2) Total Depth 81 feet.
- (3) Water Level 63 feet below top of ground.
- (4) Cased to 76, Size 2
- (5) Screen: Size 2", Length 5'
- (6) Were any formations sealed against pollution?
_____ yes, _____ no.

If YES depth of formation _____

Why _____

Drillers Remarks: _____

CODED

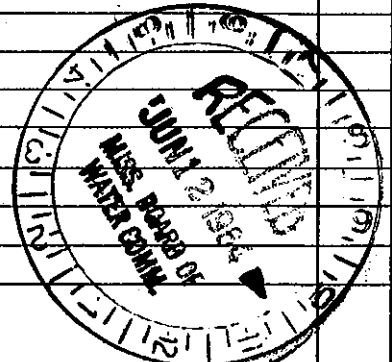

(Use Back Side)

Well No.

Mail this copy to Board of Water Commissioners 429 Miss. St. Jackson, Miss.