

ATTALA MISSISSIPPI BOARD OF WATER COMMISSIONERS

E 2001
6-10-66

WATER WELL DRILLERS LOG


Date: 6-10, 1966, Driller: Thomas & Son County ATTALA
(Name)

(1) Owner of Land:	Description & Color of Materials Sand, Clay, Red Clay, Shell, etc.	Thick- ness Feet	Depth Feet
<u>Mr. Edwards</u>	<u>CLAY</u>	<u>20</u>	<u>0</u>
<u>West, Miss</u>	<u>BLACK DIRT</u>	<u>80</u>	<u>20</u>
(Address)	<u>ROCK & SHELL</u>	<u>25</u>	<u>100</u>
(2) Location: <u>NE 1/4, SW 1/4, Sec. 2 T. 65 S.</u>	<u>GREEN SAND</u>	<u>26</u>	<u>125</u>
<u>2</u> miles <u>EAST</u> of <u>West, Miss.</u>			
(distance) (direction) (Nearest Town)			
(3) Topography: <input checked="" type="radio"/> (Hilly) <input type="radio"/> (Flat) <input type="radio"/> (Level)			
(4) Purpose of Well: <input checked="" type="radio"/> Domestic <input type="radio"/> Irrigation <input type="radio"/> Municipal, Industrial, Other			

Information upon completion of well:

- (1) Diameter 2 inches.
- (2) Total Depth 125 feet.
- (3) Water Level 68 feet below top of ground.
- (4) Cased to 105 ft. Size 2"
- (5) Screen: Size _____, Length _____
- (6) Were any formations sealed against pollution?
_____ yes, no.

If YES depth of formation _____
Why _____
Drillers Remarks: _____

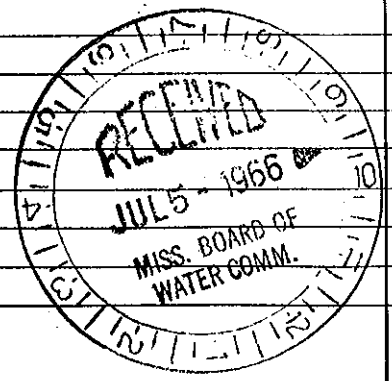

(Use Back Side)

Retain this copy for your office files.

Well No.