

5-24-62

WATER WELL DRILLERS LOG

F 12

date: 5/24, 19 62, Driller: Arnold DeLo County Attala

(Name)

CODED

(1) Owner of Land: Wayne Fulton
(Name)
Kosciusko Miss.
(Address)

(2) Location: 1/4, 1/4, Sec. 35 T. R.
6 miles N. of Kosciusko
(distance) (direction) (Nearest Town)

(3) Topography: Level
(Hilly) (Flat) (Level)

(4) Purpose of Well:
(Domestic Irrigation
Municipal, Industrial, Other)

Description & Color of Materials Sand, Clay, Red Clay, Shell, etc.	Thick- ness Feet	Depth Feet
<u>Red Clay</u>		<u>20</u>
<u>Black Shale</u>		<u>63</u>
<u>Wagon Sand</u>		<u>85</u>
<u>Black Shale</u>		<u>125</u>
<u>Gray Sand</u>		<u>185</u>
<u>Black Shale</u>		<u>273</u>
<u>Green Sand</u>		<u>375</u>

Information upon completion of well:

(1) Diameter 2 inches.

(2) Total Depth 375 feet.

(3) Water Level 40 feet below top of ground.


(4) Cased to ?, Size _____.

(5) Screen: Size P, Length _____.

(6) Were any formations sealed against pollution?
_____ yes, _____ no.

If YES depth of formation _____
Why _____

Drillers Remarks: This checked & Electric logged

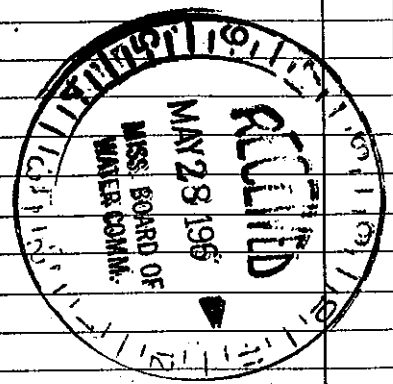

F1

(Use Back Side)

Well No.