

AF 19
5-65

WATER WELL DRILLERS LOG

CODED

Date: May, 1965, Driller: Thomas & Son County Attala
(Name)

(1) Owner of Land:	Description & Color of Materials Sand, Clay, Red Clay, Shell, etc.	Thick- ness Feet	Depth Feet
<u>JAMES BROWN</u> (Name) <u>Kosciusko, Miss.</u> (Address)	<u>Red clay</u>	<u>20</u>	<u>0</u>
(2) Location: <u>1/4</u> , <u>1/4</u> , Sec <u>31</u> T <u>15</u> R <u>6</u> E	<u>Black silt</u>	<u>80</u>	<u>20</u>
<u>11</u> miles <u>NW</u> of <u>Kosciusko</u> (distance) (direction) (Nearest Town)	<u>Rock & shell</u>	<u>35</u>	<u>100</u>
(3) Topography: <u>(Hilly)</u> (Flat) (Level)	<u>Green sand</u>	<u>36</u>	<u>135</u>
(4) Purpose of Well: <u>(Domestic)</u> Irrigation Municipal, Industrial, Other			

Information upon completion of well:


- (1) Diameter 2 inches.
 (2) Total Depth 171 feet.
 (3) Water Level 35 feet below top of ground.
 (4) Cased to 105, Size 2
 (5) Screen: Size _____, Length _____
 (6) Were any formations sealed against pollution?
 _____ yes, ✓ no.

If YES depth of formation _____

Why _____

Drillers Remarks: _____

CODED

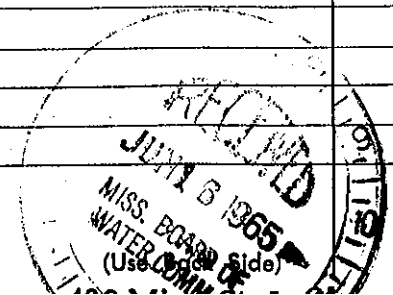

Well No. _____