

ATTALA
F 2000
5-6-66

WATER WELL DRILLERS LOG

Date: 5-6, 1966, Driller: Thomas & Son County Attala
(Name)

		Description & Color of Materials Sand, Clay, Red Clay, Shell, etc.	Thick- ness Feet	Depth Feet
(1) Owner of Land: <u>Mr. J. Flemming</u> (Name)		<u>Pipe Clay</u>	<u>20</u>	<u>0</u>
<u>Kosciusko, Miss</u> (Address)		<u>SAND & CHALK</u>	<u>15</u>	<u>20</u>
(2) Location: <u>SE 1/4, SE 1/4, Sec. 25 T15 R6</u>		<u>Black Dirt</u>	<u>88</u>	<u>35</u>
<u>7</u> miles <u>N.W.</u> of <u>Kosciusko</u>	(distance) (direction) (Nearest Town)	<u>Rock & B. Dirt</u>	<u>37</u>	<u>123</u>
(3) Topography: <u>(Hilly)</u> (Flat) (Level)		<u>Green Sand</u>	<u>32</u>	<u>155</u>
(4) Purpose of Well: <u>(Domestic)</u> Irrigation Municipal, Industrial, Other				


Information upon completion of well:

- (1) Diameter 2 inches.
- (2) Total Depth 192 feet.
- (3) Water Level 35 feet below top of ground.
- (4) Cased to 123, Size 2"
- (5) Screen: Size _____, Length _____
- (6) Were any formations sealed against pollution?
_____ yes, ✓ no.

If YES depth of formation _____

Why _____

Drillers Remarks: _____

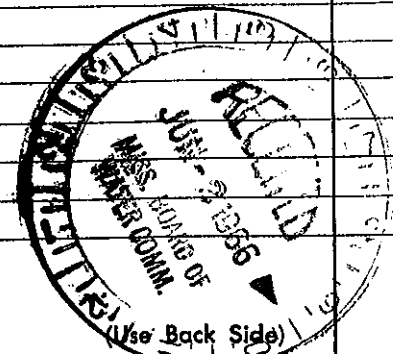

Well No. _____