

ATTALA MISSISSIPPI BOARD OF WATER COMMISSIONERS

G  
5-61

WATER WELL DRILLERS LOG

~~6307~~  
616  
Attala

Date: May, 1961, Driller: Jack Martin County Holmes  
(Name)

(1) Owner of Land:	Description & Color of Materials Sand, Clay, Red Clay, Shell, etc.	Thick- ness Feet	Depth Feet
<u>Elizabeth Teal</u> (Name)	<u>Clay</u>	<u>58</u>	<u>58</u>
<u>Kosciusko</u> (Address)	<u>Clay + Sand</u>	<u>10</u>	<u>68</u>
(2) Location: <u>SE 1/4, NE 1/4, Sec. 31 T12R7</u>	<u>Sand</u>	<u>42</u>	<u>110</u>
<u>4 1/2</u> miles <u>71 W</u> of <u>Kosciusko</u> (distance) (direction) (Nearest Town)			
(3) Topography: <u>Hilly</u> (Hilly) (Flat) (Level)			
(4) Purpose of Well: <u>Domestic</u> (Domestic Irrigation Municipal, Industrial, Other)			


Information upon completion of well:

- (1) Diameter 2 inches.
- (2) Total Depth 110 feet.
- (3) Water Level 40 feet below top of ground.
- (4) Cased to 105, Size 2
- (5) Screen: Size 2", Length 5'
- (6) Were any formations sealed against pollution?  
\_\_\_\_\_ yes,  no.

If YES depth of formation \_\_\_\_\_

Why \_\_\_\_\_

Drillers Remarks: \_\_\_\_\_

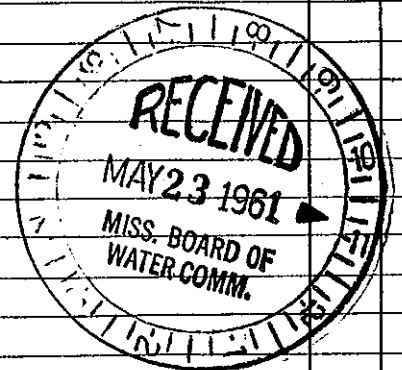

(Use Back Side)

Well No.

Mail this copy to Board of Water Commissioners 429 Miss. St. Jackson, Miss.