

ATTALA MISSISSIPPI BOARD OF WATER COMMISSIONERS

G  
7-8-60

WATER WELL DRILLERS LOG

G 300  
G 17

Date: 7-8, 1960, Driller: Smith & Presley County Attala  
(Name)

		Description & Color of Materials Sand, Clay, Red Clay, Shell, etc.	Thick- ness Feet	Depth Feet
(1) Owner of Land:	Carlos L Hooks (Name)			
	Koscisko Miss (Address)	yellow clay	20	20
(2) Location:	NE 1/4, SW 1/4, Sec. 30 T15 R7 N 6	a lighter clay	8	28
	4 miles north NW 1/4 of Koscisko (distance) (direction) (Nearest Town)	hard shale clay	10	38
(3) Topography:	Hilly (Hilly) (Flat) (Level)	hard reddish black mixed	4	42
(4) Purpose of Well:	Domestic (Domestic Irrigation Municipal, Industrial, Other)	beige color sand clay mixed with black	21	63
		blue clay sand		E.W.
		mixed	38	101
		gray sand	13	114
		white clay	8	122
		white sand	21	143


Information upon completion of well:

- (1) Diameter 2" inches.
- (2) Total Depth 143 feet.
- (3) Water Level 52 feet below top of ground.
- (4) Cased to 137, Size 2" x 1/4"
- (5) Screen: Size 1/4", Length 6'
- (6) Were any formations sealed against pollution?  
yes,  no.

If YES depth of formation \_\_\_\_\_

Why \_\_\_\_\_

Drillers Remarks: I hope the report is like you would have it to be

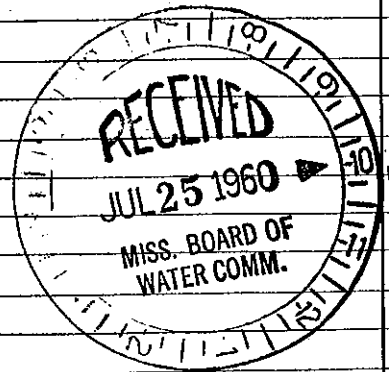

(Use Back Side)

Well No. 1