

ATTALA MISSISSIPPI BOARD OF WATER COMMISSIONERS

G 24  
5-23-63

WATER WELL DRILLERS LOG

**CODED**

Date: 5/23, 1963, Driller: Hanson Drilling Co & County Attala  
(Name)

(1) Owner of Land: <u>E. G. Strickland</u> (Name)	Description & Color of Materials Sand, Clay, Red Clay, Shell, etc.	Thick- ness Feet	Depth Feet
(Address)	<u>Hard clay</u>	<u>2.5</u>	<u>2.5</u>
(2) Location: <u>1/4, 1/4, Sec. 2 T. 15 R. 7</u>	<u>Shaly sand</u>	<u>3.0</u>	<u>5.5</u>
<u>9</u> miles <u>N</u> , of <u>Nasau</u> (distance) (direction) (Nearest Town)	<u>Yellow sand</u>	<u>3.5</u>	<u>9.0</u>
(3) Topography: <u>Flat</u> (Hilly) (Flat) (Level)	<u>Brown sand</u>	<u>3.0</u>	<u>12.0</u>
(4) Purpose of Well: <u>Domestic</u> (Domestic Irrigation Municipal, Industrial, Other)	<u>Sand &amp; blue shale</u>	<u>2.0</u>	<u>14.0</u>
	<u>Coarse dark sand</u>	<u>2.0</u>	<u>16.0</u>
	<u>Sand &amp; shale</u>	<u>1.0</u>	<u>17.0</u>
	<u>Coarse grey sand</u>	<u>1.4</u>	<u>18.4</u>

Information upon completion of well:


- (1) Diameter 2 inches.
- (2) Total Depth 184 feet.
- (3) Water Level 70 feet below top of ground.
- (4) Cased to \_\_\_\_\_, Size \_\_\_\_\_.
- (5) Screen: Size 2 1/2", Length 5'  
well, steel
- (6) Were any formations sealed against pollution?  
\_\_\_\_\_ yes; \_\_\_\_\_ no.

If YES depth of formation \_\_\_\_\_

Why \_\_\_\_\_

Drillers Remarks: \_\_\_\_\_

**CODED**

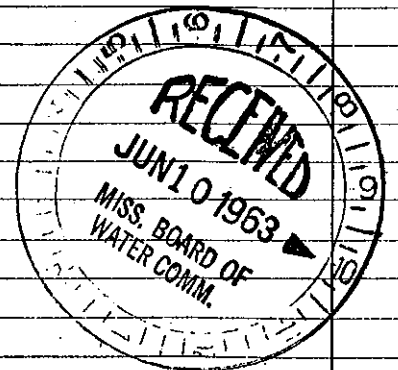

(Use Back Side)

Well No.

Mail this copy to Board of Water Commissioners 429 Miss. St. Jackson, Mis