



MISSISSIPPI BOARD OF WATER COMMISSIONERS
ATTALA


G 29
6-61

WATER WELL DRILLERS LOG

10-16-04-29
10-302

Date: _____, 19____, Driller: Smith & Presley Attala
 (Name)

		Description & Color of Materials Sand, Clay, Red Clay, Shell, etc.	Thick- ness Feet	Depth Feet
(1) Owner of Land: <u>George R Patrick</u> (Name) <u>R. I. Kosciuszko</u> (Address)		<u>yellow clay</u>	<u>20</u>	<u>20</u>
(2) Location: <u>E 2 1/4, S 1/4, Sec. 27 T5 R1</u> (Address) <u>5 miles north</u> , of <u>Kosciusko</u> (distance) (direction) (Nearest Town)		<u>yellow clay with</u> <u>a black limestone</u>	<u>10</u>	<u>30</u>
(3) Topography: <u>Hilly</u> (Hilly) (Flat) (Level)		<u>blue clay</u> <u>brown silt blue</u> <u>clay mixture</u>	<u>11</u> <u>7</u>	<u>41</u> <u>48</u>
(4) Purpose of Well: <u>Domestic</u> (Domestic Irrigation Municipal, Industrial, Other)		<u>white clay brownish</u> <u>mixture</u> <u>blue clay</u> <u>hard shale</u>	<u>15</u> <u>11</u> <u>4"</u>	<u>63</u> <u>74</u>
Information upon completion of well:		<u>blue clay</u> <u>hard shale</u> <u>blue clay black</u> <u>mixture with a little sand</u> <u>blue clay black and</u> <u>brown mixture</u> <u>hard shale about</u> <u>blue clay brown</u> <u>shale mixture</u> <u>blue clay and green sand</u> <u>blue clay green</u> <u>sand</u> <u>green sand</u> <u>hard pan</u> <u>white sand</u>	<u>3</u> <u>4"</u> <u>7</u> <u>16</u> <u>3'</u> <u>13</u> <u>35</u> <u>15</u> <u>16</u> <u>3"</u> <u>16</u>	<u>77</u> <u>84</u> <u>100</u> <u>113</u> <u>148</u> <u>163</u> <u>179</u> <u>195</u>
(1) Diameter <u>2</u> inches.				
(2) Total Depth <u>195</u> feet.				
(3) Water Level <u>120</u> feet below top of ground.				
(4) Cased to <u>189</u> , Size <u>2"</u>				
(5) Screen: Size <u>1 1/4</u> , Length <u>6'</u>				
(6) Were any formations sealed against pollution? _____ yes, _____ no.				
If YES depth of formation _____				
Why _____				
Drillers Remarks: _____				

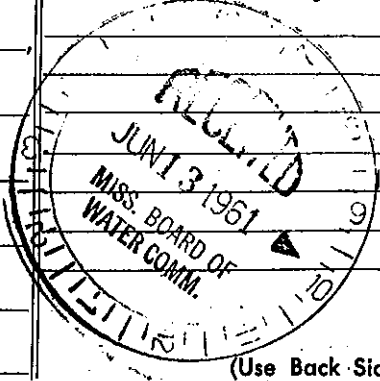

Well No. _____

Mail this copy to Board of Water Commissioners 429 Miss. St. Jackson, Miss.