

ATTALA MISSISSIPPI BOARD OF WATER COMMISSIONERS

62000

12-21-62 WATER WELL DRILLERS LOG

Date: 12-21, 1962, Driller: Thomas & Son County ATTALA  
(Name)

		Description & Color of Materials Sand, Clay, Red Clay, Shell, etc.	Thick- ness Feet	Depth Feet
(1) Owner of Land:	O. S. Bradberry (Name)	Red Clay	20	0
	Kosciusko, Miss. (Address)	SAND & CHALK	85	20
(2) Location:	9A 1/4, SW 1/4, Sec. 32 T45R2, (distance) (direction) (Nearest Town)	Blue Dirt w/ Rock & Shell	15	105
	3 miles North of Kosciusko, (distance) (direction) (Nearest Town)	Green SAND	22	120
(3) Topography:	Hilly (Hilly) (Flat) (Level)			142
(4) Purpose of Well:	Domestic (Domestic Irrigation Municipal, Industrial, Other)			


Information upon completion of well:

- (1) Diameter 2 inches.
- (2) Total Depth 142 feet.
- (3) Water Level 12 feet below top of ground.
- (4) Cased to 108 1/2, Size 2"
- (5) Screen: Size \_\_\_\_\_, Length \_\_\_\_\_.
- (6) Were any formations sealed against pollution?  
\_\_\_\_\_ yes,  no.

If YES depth of formation \_\_\_\_\_

Why \_\_\_\_\_

Drillers Remarks: \_\_\_\_\_

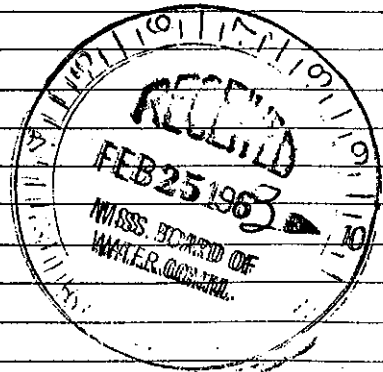

(Use Back Side)

Well No.

Mail this copy to Board of Water Commissioners 429 Miss. St. Jackson, Miss.