

ATTALA MISSISSIPPI BOARD OF WATER COMMISSIONERS

2 2052

9-4-64 WATER WELL DRILLERS LOG

Date: 9-4, 1964 Driller: Smith & Prusley County Attala

		Description & Color of Materials Sand, Clay, Red Clay, Shell, etc.	Thick- ness Feet	Depth Feet
(1) Owner of Land: <u>R. P. Cummings</u> (Name) <u>R. Kosciusko Miss.</u> (Address)		<u>yellow clay</u>	<u>18</u>	<u>18</u>
(2) Location: <u>NW 1/4, NE 1/4, SE 1/4, Sec 29 T15R7</u> <u>4 1/2</u> miles <u>North</u> of <u>HX 43</u> (distance) (direction) (Nearest Town)		<u>yellow clay</u> <u>brown sand</u> <u>a black speck</u> <u>mixture</u>	<u>46</u>	<u>64</u>
(3) Topography: <u>Hilly</u> (Hilly) (Flat) (Level)		<u>white sand</u> <u>with a little</u> <u>blue clay mix</u>	<u>3</u>	<u>67</u>
(4) Purpose of Well: <u>Domestic</u> (Domestic Irrigation Municipal, Industrial, Other)		<u>white medium</u> <u>sand</u>	<u>71</u>	<u>74</u>


Information upon completion of well:

- (1) Diameter 2 inches.
- (2) Total Depth 74 feet.
- (3) Water Level 40 feet below top of ground.
- (4) Cased to 68, Size 2
- (5) Screen: Size 1/2", Length 6"
- (6) Were any formations sealed against pollution?
 yes, no.

If YES depth of formation _____

Why _____

Drillers Remarks: _____

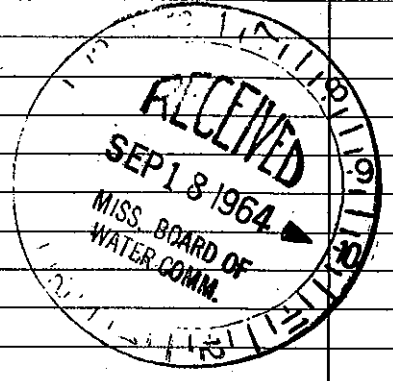

Well No. 53

(Use Back Side)

Mail this copy to Board of Water Commissioners 429 Miss. St. Jackson, Miss.