

ATTALA
 G. 2003
 7-68

MISSISSIPPI
 BOARD OF WATER COMMISSIONERS
 416 North State Street
 Jackson, Mississippi 39201

WATER WELL DRILLERS LOG

7-19-1968 date well completed
 Smith Forge & Welding firm name
 Attala county well located


LANDOWNER: Mason Tanner
 R2
 Rosemont Miss
 (mailing address)

WELL LOCATION: NE 1/4 Sec 36 T15N R7E
 0 miles N of Rosemont
 (distance) (direction) (nearest town)

WELL PURPOSE: Home
 (home, irrigation, municipal, industrial)

- WELL COMPLETION DATA:
- (1) diameter (inches) 2"
 - (2) total depth (feet) 145
 - (3) static water level (feet) 40 below above top of ground.
 - (4) casing 2" galv. (material) (depth)
 (size) if telescope see back.
 - (5) screen 6' (length) (depth to top)
 1/4" Copper or Brass (size) (material)
 - (6) pump 1/4 (HP) about 300 H (yield gpm) 5 HPM
 Electricity (type power)
 - (7) electric log NO (yes or no)
 (organization running log)
 - (8) how well bottom plugged

description of formations encountered	from	to
red clay	0	4
sand track	4	9
white clay	9	17
rock thin layers	17	21
gray clay	21	37
other layers		
bd rock	37	56
gray sand	56	66
blue sand	66	96
blue clay	96	98
light blue sand	98	118
streak of blue clay	118	124
gray sand	124	140

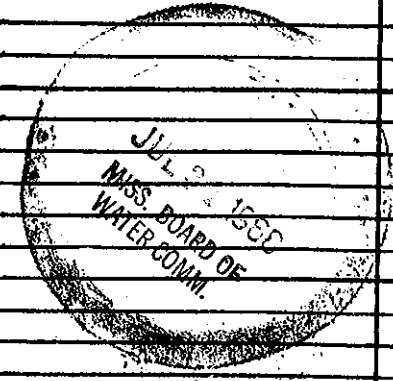

DRILLERS REMARKS: