

H 23

1-3-63

WATER WELL DRILLERS LOG

CODED *afala*Date: Jan 3, 1963, Driller: Rabert E. Rathoff County: ~~Howard~~

(Name)

| (1) Owner of Land: <u>Ethel Miss</u> (Name) | Description & Color of Materials Sand, Clay, Red Clay, Shell, etc. | Thick- ness Feet | Depth Feet |
|--|---|------------------------|---------------|
| <u>Ethel Miss</u> (Address) | <u>0-23 red clay</u> | | |
| (2) Location: <u>1/4, 1/4, Sec. ²⁷ 39 T5 R8</u> | <u>23-46 Red clay clay streaks</u> | | |
| _____ miles _____ of _____ (distance) (direction) (Nearest Town) | <u>46-68 Sand Clay streaks</u> | | |
| (3) Topography: _____ (Hilly) (Flat) (Level) | <u>68-90 sand</u> | | |
| (4) Purpose of Well: <u>Municipal</u> (Domestic Irrigation Municipal, Industrial, Other) | <u>90-111 shale</u> | | |
| | <u>111-136 sand shale streaks</u> | | |
| | <u>136-155 " " "</u> | | |
| | <u>155-167 sand</u> | | |
| | <u>167-198 "</u> | | |
| | <u>198-208 "</u> | | |
| | <u>208-210 shale</u> | | |

Information upon completion of well:


- (1) Diameter 6X8 inches.
- (2) Total Depth 210 feet.
- (3) Water Level 91 feet below top of ground.
- (4) Cased to 210, Size 6X8.
- (5) Screen: Size 020, Length 40'.
- (6) Were any formations sealed against pollution?
X yes, _____ no.

If YES depth of formation _____

Why _____

Drillers Remarks: _____

CODED

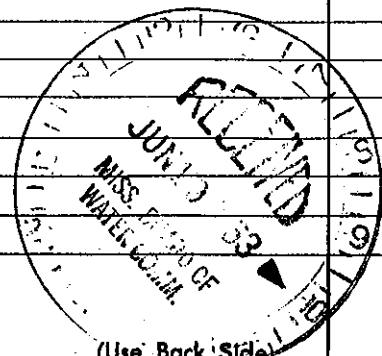

Well No