

H 2001

WATER WELL DRILLERS LOG

7-23-63

Date: 7-23, 1963, Driller: Smith & Presley County *Attala*

(Name)

(1) Owner of Land: Certes Kintrough
(Name)
McCool Miss
(Address)

(2) Location: N 1/4, S 1/4, Sec. 3 T16R8
7 miles West, of McCool
(distance) (direction) (Nearest Town)

(3) Topography: Hilly
(Hilly) (Flat) (Level)

(4) Purpose of Well: Domestic
(Domestic Irrigation
Municipal, Industrial, Other)

Description & Color of Materials Sand, Clay, Red Clay, Shell, etc.	Thick- ness Feet	Depth Feet
red sand	14	14
black clay	14	28
black clay with trace of sand	30	58
in and out of sand	30	88
blue clay with a sand mix- ture	21	109
in and out of sand	20	129
blue clay	3	132
fine white sand blue clay mixture	12	144
fine white sand	6	150
a good grad of white sand	9	159


Information upon completion of well:

- (1) Diameter 2 inches.
- (2) Total Depth 159 feet.
- (3) Water Level 35 feet below top of ground.
- (4) Cased to 153, Size 2 X 1 1/4.
- (5) Screen: Size 1 1/4, Length 6".
- (6) Were any formations sealed against pollution?
_____ yes, No no.

If YES depth of formation _____

Why _____

Drillers Remarks: _____

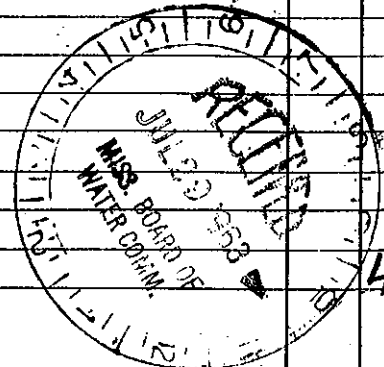

(Use Back Side)

Well No. 44