

H 2002

3-14-66

WATER WELL DRILLERS LOG

Date: 3-14, 1966, Driller: Smith Forge DeWitt county Attala
(Name)

(1) Owner of Land:	Description & Color of Materials Sand, Clay, Red Clay, Shell, etc.	Thick- ness Feet	Depth Feet
<u>Ramon Pae</u> (Name)	<u>top soil</u>	<u>2</u>	<u>2</u>
<u>Ethel Miss</u> (Address)	<u>red sand</u>	<u>55</u>	<u>57</u>
	<u>white sand</u>	<u>13</u>	<u>70</u>
(2) Location: <u>SW 1/4, N 8 1/4, Sec. 33 T16 R 8,</u> <u>1 1/2 miles S W</u> of <u>Ethel</u> (distance) (direction) (Nearest Town)			
(3) Topography: <u>Hilly</u> (Hilly) (Flat) (Level)			
(4) Purpose of Well: <u>domestic</u> (Domestic Irrigation Municipal, Industrial, Other)			


Information upon completion of well:

- (1) Diameter 2 inches.
- (2) Total Depth 70 feet.
- (3) Water Level 38 feet below top of ground.
- (4) Cased to 64, Size _____.
- (5) Screen: Size 1 1/4, Length 6'
- (6) Were any formations sealed against pollution?
_____ yes, X no.

If YES depth of formation _____

Why _____

Drillers Remarks: _____

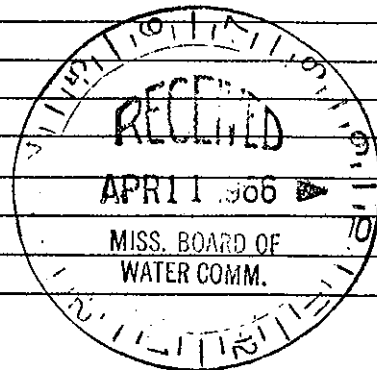

JPM