

ATTALA MISSISSIPPI BOARD OF WATER COMMISSIONERS

J


12-6-60

WATER WELL DRILLERS LOG

J 300
J 4

Date: 12-6, 1960, Driller: Smith K P Preley County Attala
(Name)

		Description & Color of Materials Sand, Clay, Red Clay, Shell, etc.	Thick- ness Feet	Depth Feet
(1) Owner of Land: <u>Mr. Lee Lamin</u> (Name)		<u>red clay</u>	<u>3</u>	<u>3</u>
<u>R. J. B. McCool Miss</u> (Address)		<u>red sand</u>	<u>10</u>	<u>13</u>
(2) Location: <u>E 2 1/4 SW 1/4, Sec. 4 T15 R9</u> <u>2</u> miles <u>SW</u> of <u>McCoal</u> (distance) (direction) (Nearest Town)		<u>white sand clay</u>	<u>4</u>	<u>17</u>
(3) Topography: <u>hilly</u> (Hilly) (Flat) (Level)		<u>mixed</u>	<u>10</u>	<u>27</u>
(4) Purpose of Well: <u>domestic</u> (Domestic Irrigation Municipal, Industrial, Other)		<u>light colored</u>	<u>53</u>	<u>80</u>
Information upon completion of well:		<u>clay</u>	<u>49</u>	<u>129</u>
(1) Diameter <u>2</u> inches.		<u>blue clay mixed</u>	<u>55</u>	<u>184</u>
(2) Total Depth <u>425</u> feet.		<u>with a little sand</u>		
(3) Water Level <u>45</u> feet below top of ground.		<u>about</u>	<u>1</u>	<u>185</u>
(4) Cased to <u>187</u> , Size <u>2'</u>		<u>coarse sand</u>	<u>12</u>	<u>200</u>
(5) Screen: Size <u>non</u> , Length _____		<u>solid blue clay</u>	<u>115</u>	<u>215</u>
(6) Were any formations sealed against pollution? yes, <u>X</u> no.		<u>light green silt</u>	<u>30</u>	<u>245</u>
If YES depth of formation _____		<u>light green silt</u>	<u>3</u>	<u>278</u>
Why _____		<u>black about gray</u>	<u>45</u>	<u>323</u>
Drillers Remarks: <u>no water</u>		<u>gray silt</u>	<u>29</u>	<u>352</u>
<u>sand to be found</u>		<u>red brown clay and</u>	<u>4</u>	<u>356</u>
<u>at this dep. plenty</u>		<u>lignite</u>	<u>69</u>	<u>425</u>
<u>good water</u>		<u>rock</u>		
		<u>blue clay and lignite</u>		

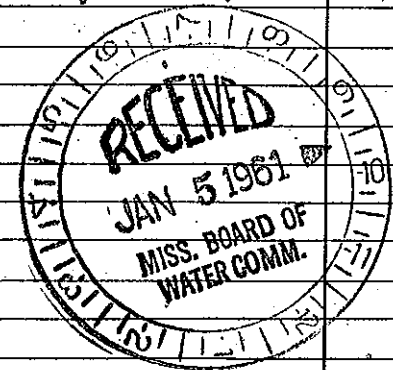

(Use Back Side)

Mail this copy to Board of Water Commissioners 429 Miss. St. Jackson, Miss.

Well No. 8