

ATTALA

MISSISSIPPI BOARD OF WATER COMMISSIONERS

059  
7-3-62

WATER WELL DRILLERS LOG

**CODED** ATTALA

Date: 7/3/62 1962, Driller: L. K. Merritt County Attala

HUNT  
(Name)

		Description & Color of Materials Sand, Clay, Red Clay, Shell, etc.	Thick- ness Feet	Depth Feet
(1) Owner of Land:	<u>Kenneth Hunt</u> (Name) <u>McCool, Miss.</u> (Address)	<u>Red. Sumpen Clay</u>	<u>0</u>	<u>14</u>
(2) Location:	<u>1/4, 1/4, Sec. 2 T15R9</u> miles <u>in</u> <u>McCool</u> (distance) (direction) (Nearest Town)	<u>Hard Blue Clay</u>	<u>14</u>	<u>29</u>
(3) Topography:	<input checked="" type="checkbox"/> (Hilly) <input type="checkbox"/> (Flat) <input type="checkbox"/> (Level)	<u>Hard Lignite</u>	<u>29</u>	<u>31</u>
(4) Purpose of Well:	<u>Domestic</u> (Domestic Irrigation Municipal, Industrial, Other)	<u>Med. Hard Blue Clay</u>	<u>31</u>	<u>43</u>
		<u>Soft Blue Clay, Shale</u>		
		<u>Trace of Blue powder</u>	<u>43</u>	<u>55</u>
		<u>Sand</u>		
		<u>Blue powder, sand</u>	<u>55</u>	<u>115</u>
		<u>Trace of Shale &amp; clay</u>	<u>115</u>	<u>126</u>
		<u>Blue Clay</u>		

Information upon completion of well:


- (1) Diameter 2 inches.
- (2) Total Depth 126 feet.
- (3) Water Level 35 feet below top of ground.
- (4) Cased to 51, Size 2.
- (5) Screen: Size 1/2, Length \_\_\_\_\_.
- (6) Were any formations sealed against pollution?  
 yes, \_\_\_\_\_ no.

If YES, depth of formation \_\_\_\_\_

Why \_\_\_\_\_

Drillers Remarks: \_\_\_\_\_

**CODED**

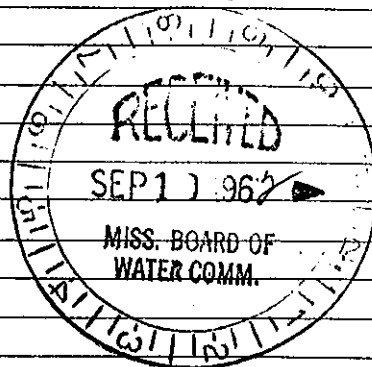

(Use Back Side)

Well No.

Mail this copy to Board of Water Commissioners 429 Miss. St. Jackson, Miss.