

ATTALA
J 2002
6/81

MISSISSIPPI
BOARD OF WATER COMMISSIONERS
416 North State Street
Jackson, Mississippi 39201

WATER WELL DRILLERS LOG

June 1981 Thomas ATTALA
date well completed firm name county well located


LANDOWNER: C. A. Dety
French Camp
(mailing address)

WELL LOCATION:
sec. 31 T. 15 N R. 9 E
4 miles W of McCord
(distance) (direction) (nearest town)

WELL PURPOSE:
(home, irrigation, municipal, industrial)

- WELL COMPLETION DATA:
- (1) diameter (inches) 2
 - (2) total depth (feet) 80
 - (3) static water level (feet) 60 below top of ground
 - (4) casing 1/2 70
(material) (depth)
2 (size) if telescope see back.
 - (5) screen 10 70
(length) (depth to top)
2" 1/2 slot 1/2
(size) (material)
 - (6) pump 1 6
(HP) (yield gpm)
Elec (type power)
 - (7) electric log N/O
(yes or no)
(organization running log)
 - (8) how well bottom plugged fair

description of formations encountered	from	to
Red Clay	0	15
SAND	15	30
CHALK	30	33
Rock	33	34
Black dirt	34	46
Rock	46	50
CHALK & B. dirt	50	60
SAND	60	80

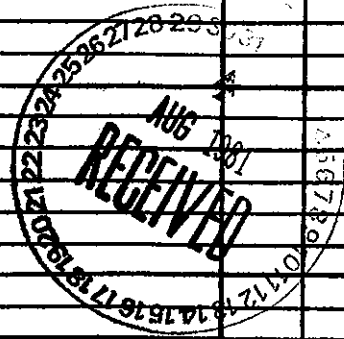

DRILLERS REMARKS: