


Attala
K15

MISSISSIPPI BOARD OF WATER COMMISSIONERS

11-66
Log # 25

WATER WELL DRILLERS LOG

Date: 11/1, 1966, Driller: Braswell Drilling Co. County: Attala

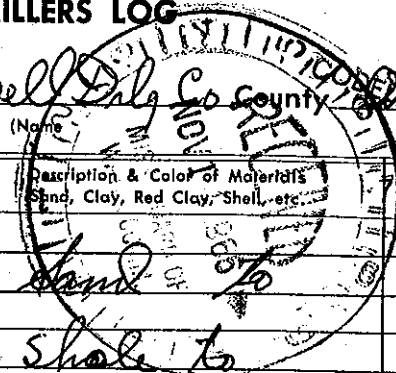

(1) Owner of Land:	Description & Color of Materials Sand, Clay, Red Clay, Shell, etc.	Thickness Feet	Depth Feet
Sallis Community (Name) Sallis Miss. (Address)	Sand to		210
(2) Location: NW 1/4, NW 1/4, Sec. 35 T14N R5E (distance) (direction) (Nearest Town)	Shale to		345
0 miles N. Side of Sallis (distance) (direction) (Nearest Town)	Green Sand		500
(3) Topography: Hilly (Hilly) (Flat) (Level)	Water shale, rock & sand		
(4) Purpose of Well: Community system (Domestic Irrigation, Municipal, Industrial, Other)	streaks to		575

Information upon completion of well:

- (1) Diameter: 2" Test inches.
- (2) Total Depth: 655 feet.
- (3) Water Level: 65 feet below top of ground.
- (4) Cased to: 655, Size _____
- (5) Screen: Size 80/100, Length _____
- (6) Were any formations sealed against pollution?
_____ yes, _____ no.

If YES depth of formation _____

Why _____

Drillers Remarks:

(Electric Log)
U. S.

Elevation 80' above R.R.
PROVED

Retain this copy for your office files.

(Use Back Side)

Well No.