

ATTALA MISSISSIPPI BOARD OF WATER COMMISSIONERS

K17

WATER WELL DRILLERS LOG

CODED

12-19-63

Date: 12-15, 1963, Driller: Smith & Presley, county Attala

(Name)

(1) Owner of Land: Felix Leonard
(Name)
Sallis miss
(Address)

(2) Location: 1/4, 1/4, Sec. 33 T4 R5
3 1/2 miles west of Sallis
(distance) (direction) (Nearest Town)

(3) Topography: medium Hilly
(Hilly) (Flat) (Level)

(4) Purpose of Well: Domestic
(Domestic Irrigation
Municipal, Industrial, Other)

Description & Color of Materials Sand, Clay, Red Clay, Shell, etc.	Thick- ness Feet	Depth Feet
yellow clay	16	16
white sand	4	20
yellow clay	2	22
black clay	42	64
blue clay	22	86
black clay	149	235
a series of thin rock	1	237
rock	8"	
blue clay	20	257
light blue clay with a redish mixture	30	287
blue clay	22	309
hard pan blue clay sponge with shell mixture	20	329
clay green sand mixture of sponge and a bit of stone		
shell mixture	20	349
a little better grade of green sand	12	361
clay	5	366

Information upon completion of well:

(1) Diameter 2 inches.

(2) Total Depth 366 feet.

(3) Water Level 20 feet below top of ground.

(4) Cased to 231, Size 2


(5) Screen: Size 1/10, Length X

(6) Were any formations sealed against pollution?
_____ yes, _____ no.

If YES depth of formation _____

Why _____

Drillers Remarks:
Open Well

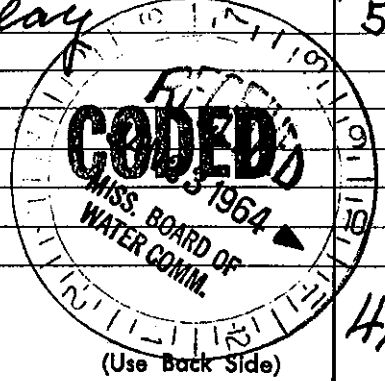

Well No. 49

(Use Back Side)

Mail this copy to Board of Water Commissioners 429 Miss. St. Jackson, Miss.