

ATTALA

MISSISSIPPI BOARD OF WATER COMMISSIONERS

K 18

4-65

WATER WELL DRILLERS LOG

**CODED**

Date: April, 1965, Driller: Jack Martin County Nalmer  
(Name)

(1) Owner of Land: <u>John Fleming</u> (Name) <u>Sallie</u> (Address)	Description & Color of Materials Sand, Clay, Red Clay, Shell, etc.	Thick- ness Feet	Depth Feet
	<u>Clay</u>	<u>10</u>	<u>10</u>
	<u>Pipe Clay</u>	<u>18</u>	<u>28</u>
(2) Location: <u>26</u> / <u>27</u> <u>14</u> <u>RS</u> <u>2</u> miles <u>NW</u> of <u>Sallie</u> (distance) (direction) (Nearest Town)	<u>Mud</u>	<u>48</u>	<u>76</u>
(3) Topography: <u>Hilly</u> (Hilly) (Flat) (Level)	<u>Sand</u>	<u>45</u>	<u>121</u>
(4) Purpose of Well: <u>Domestic</u> (Domestic Irrigation Municipal, Industrial, Other)	<u>Mud</u>	<u>89</u>	<u>210</u>

Information upon completion of well:

(1) Diameter 2 inches.

(2) Total Depth 280 feet.

(3) Water Level 14 feet below top of ground.

(4) Cased to 271, Size 2

(5) Screen: Size 2, Length 9

(6) Were any formations sealed against pollution?  
 yes,  no.


If YES depth of formation \_\_\_\_\_

Why \_\_\_\_\_

Drillers Remarks: \_\_\_\_\_

Description & Color of Materials Sand, Clay, Red Clay, Shell, etc.	Thick- ness Feet	Depth Feet
<u>rock layers</u>	<u>195 to</u>	<u>198</u>
<u>sand-shell-sand</u>	<u>28</u>	<u>238</u>
<u>sand</u>	<u>42</u>	<u>280</u>

**CODED**

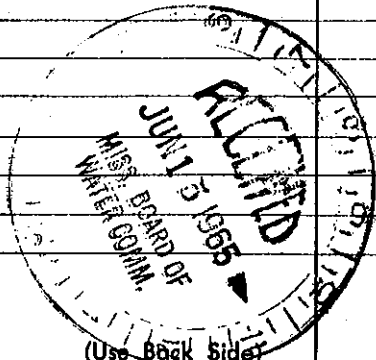

Well No.

Mail this copy to Board of Water Commissioners 429 Miss. St. Jackson, Miss.