

ATTALA

K

WATER WELL DRILLERS LOG


K23

2-8-62

Date: 2-8, 1962, Driller: Smith & Presley County Attala

(Name)

(1) Owner of Land: Gladys Holman (Name)	Description & Color of Materials Sand, Clay, Red Clay, Shell, etc.	Thick- ness Feet	Depth Feet
Sallis' niece (Address)	Yellow Clay	5	5
(2) Location: NE 1/4, E 2 1/4, Sec. 22 T14R5, 2 1/4 miles North of Sallis (distance) (direction) (Nearest Town)	Yellow white clay mixture with a redish mixture	11	11
(3) Topography: Hilly (Hilly) (Flat) (Level)	White Clay	10	21
(4) Purpose of Well: Domestic (Domestic Irrigation Municipal, Industrial, Other)	White Clay & shell mix	9	30
Information upon completion of well:	White Clay with a trace of sand	3	33
(1) Diameter 2 inches.	White Clay	7	40
(2) Total Depth 69 feet.	White Clay & sand mixture	9	49
(3) Water Level 35 feet below top of ground.	Sand very fine	10	59
(4) Cased to 63, Size 2	White Sand	10	69
(5) Screen: Size 1/4, Length 6'	good grade		
(6) Were any formations sealed against pollution? yes, no.			
If YES depth of formation			
Why			
Drillers Remarks:			

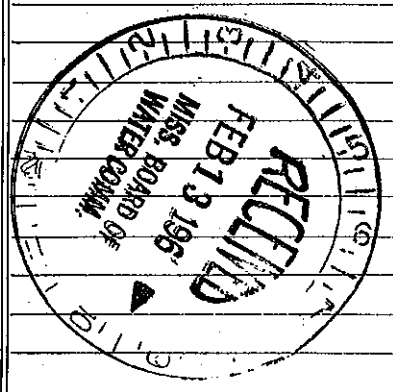

(Use Back Side)

16 Well No.

Mail this copy to Board of Water Commissioners 429 Miss. St. Jackson, Miss.