

ATTALA MISSISSIPPI BOARD OF WATER COMMISSIONERS

K
5-22-62

WATER WELL DRILLERS LOG

K 30
ATTALA

Date: 5-22, 1962, Driller: Thomas & Son County ~~Attala~~

(Name)

(1) Owner of Land: <u>Maris Culpepper</u> (Name)	Description & Color of Materials Sand, Clay, Red Clay, Shell, etc.	Thick- ness Feet	Depth Feet
<u>Durant Miss.</u> (Address)	Dirt & sand		0-20
<u>1/2 of SE 1/4, Sec 19 T14R5</u>	Black dirt	65	85
<u>2 miles East</u> of <u>Durant</u> (distance) (direction) (Nearest Town)	Sand	60	145
(3) Topography: <input checked="" type="radio"/> (Hilly) <input type="radio"/> (Flat) <input type="radio"/> (Level)	Rock	28 in	148
(4) Purpose of Well: <u>Domestic</u> (Domestic Irrigation, Municipal, Industrial, Other)	Sand		251


→ There was some sand & some chalk. But we got no returns so uncertain as to exactly what & where.

Information upon completion of well:

- (1) Diameter 2 inches.
- (2) Total Depth 251 feet.
- (3) Water Level 88 feet below top of ground.
- (4) Cased to 145, Size 2
- (5) Screen: Size _____, Length _____
- (6) Were any formations sealed against pollution?
see below
_____ yes, _____ no.

If YES depth of formation 147
Why _____

Drillers Remarks: Hit one crack between 2 rocks at 147 ft. & was unable to seal off.

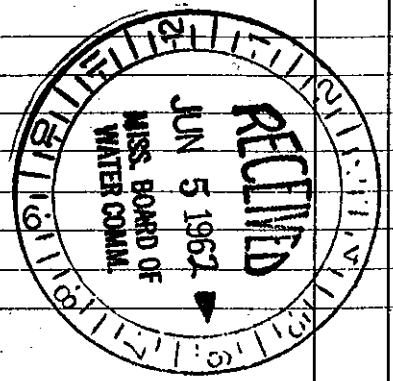

(Use Back Side)

Well No.

Mail this copy to Board of Water Commissioners 429 Miss. St. Jackson, Mis