

Attala  
~~K. 45~~  
 K. 45  
~~K. 45~~

Bureau of Land and Water Resources  
 Southport Mall  
 P.O. Box 10631  
 Jackson, Mississippi 39209  
**WATER WELL DRILLERS LOG**

6015522

Griner Drilling Serv Attala  
 firm name county well located

5/23 2000  
 19 date well completed

DUKE ENERGY  
 M&A Adams  
 Project

LANDOWNER: William Cain  
 RT#2 Box 49

description of formations encountered  
 SITE #1 Well #2  
 50' SOUTH OF SITE #1 WELL #1

SALLIS Ms. 37160  
 (mailing address)

WELL LOCATION:  
 SE 35 T. 14 N R. 4 E  
 last side of Big Black R. South east of Durant  
 (distance) miles (direction) (nearest town)

See T.H #1  
 (30' away)  
 Clay w/ SAND 0 20  
 Sand 20 90

WELL PURPOSE: Test/Obs well  
 (home, irrigation, municipal, industrial)

\*  
 DUKE ENERGY Test/OBS  
 WELL ON CAIN PROPERTY

WELL COMPLETION DATA:

- (1) diameter (inches) 4"
- (2) total depth (feet) 90
- (3) static water level (feet) 12 (below top of ground above)
- (4) casing PVC 60 (material) (depth)  
 (size) If telescope see back.
- (5) screen 30' 60 (length) (depth to top)  
 4" (size) (dia) PVC (material)
- (6) pump None (HP) (yield gpm)  
 None (type power)
- (7) electric log (yes or no) (no)
- (organization running log)
- (8) how well bottom plugged

Well to be left  
 at owners request  
 for domestic use

DO NOT REMOVE ORIGINALS

Rec  
 3/14

RECEIVED  
 JAN 23 2003  
 BY: OLWR

DRILLERS REMARKS: \*

# GRINER DRILLING SERVICE, INC.

TELEPHONE 601/736-6347

P. O. DRAWER 825

COLUMBIA, MS 39429

PAGE 1 OF 1

FORMATION LOG FOR DUKE ENERGY - ATTALA COUNTY

<b>TEST HOLE NO.</b> <u>2</u>	ADDRESS _____
	TEST HOLE LOCATION <u>CAIN PROPERTY</u>


## FORMATION AND TEST HOLE INFORMATION

TOTAL DEPTH	THICKNESS EACH STRATUM	FORMATION	REMARKS
20	20	CLAY WITH SAND	
40	20	SAND	
60	20	SAND	
80	20	SAND	
90	10	SAND WITH CLAY	

Date Started \_\_\_\_\_ Date Completed \_\_\_\_\_

\_\_\_\_\_  
Field Engineer  
\_\_\_\_\_  
Driller

DUKE ENERGY - ATTALA COUNTY, MISSISSIPPI  
CAIN PROPERTY SECTION 35 TOWNSHIP 14 N RANGE 4 E  
WELL OBSERVATION, SITE NO. 1, WELL NO. 2  
LOCATED ON WEST END OF FIELD 50 FT. SOUTH OF 250 FT. WELL  
FORMATION: SPARTA

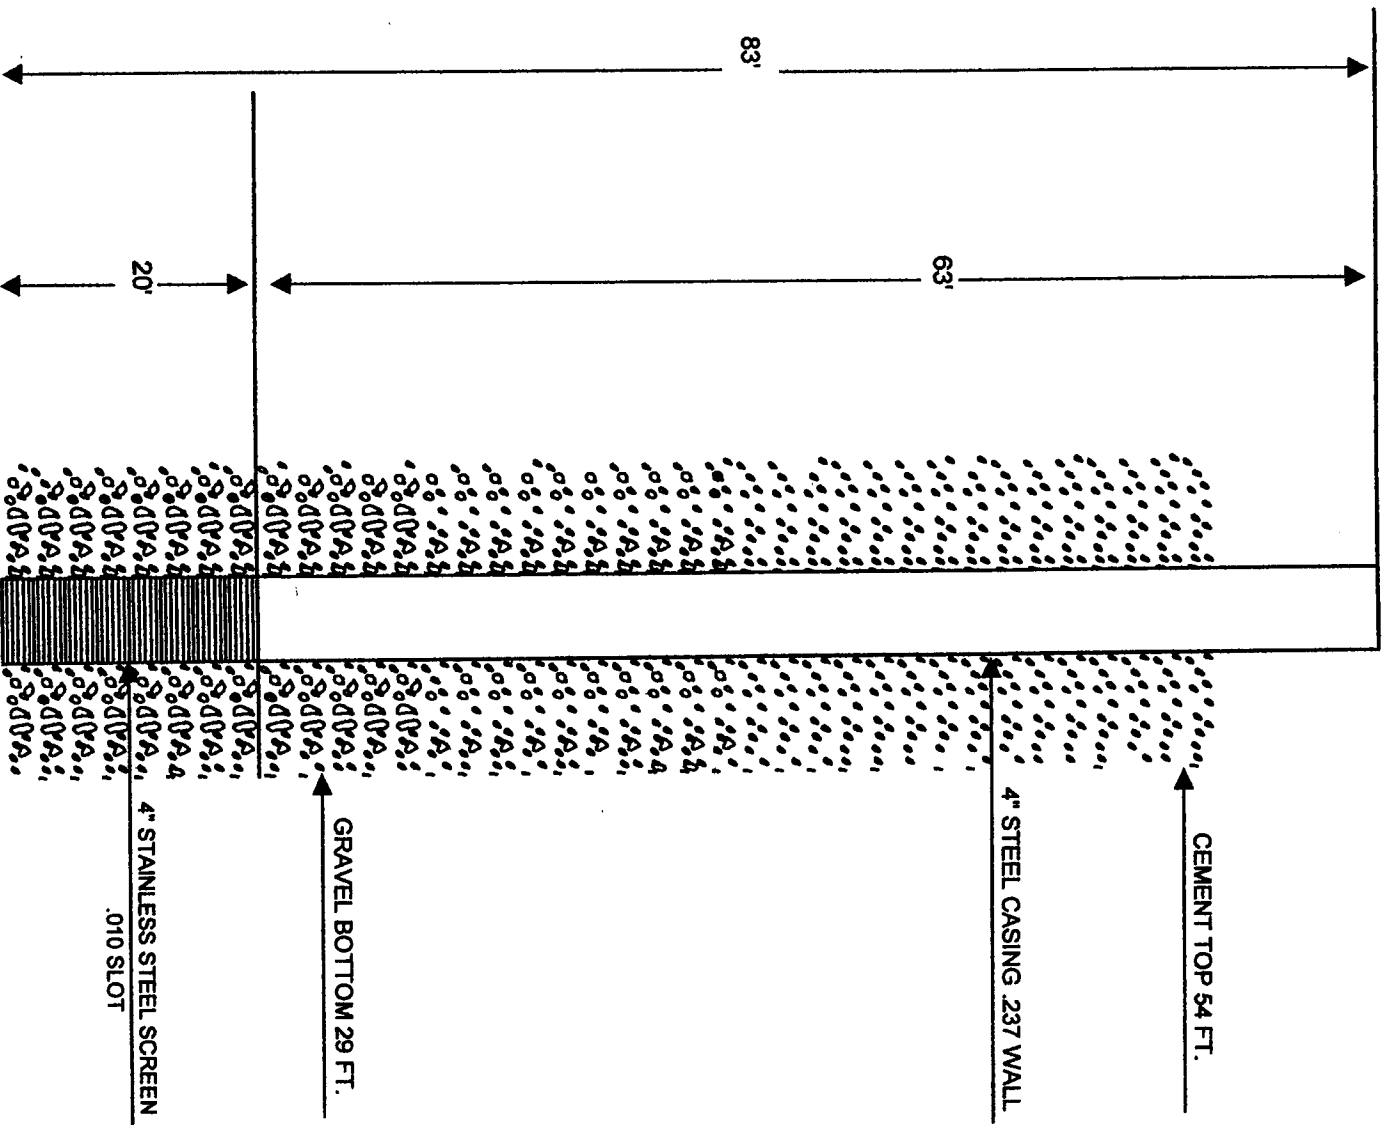

Wells	Permit #	Sec	Twn	Rng	Date	Owner	Depth	Case	Stat	Case	Inch	Bozn	Pump	Set	HP	Cap.	Use
K2016	MS-GW-00998	35	14N	05E	23-MAY-68	SALLIS MUNICIPAL WATER S	622	10	10	575	41	200	150	10	150	SB	
K0022		35	14N	05E	01-JAN-08	SALLIS MUNICIPAL WATER S	356	2	2	300	56	0	0	0	0	UN	
K0041	MS-GW-15387	27	14N	05E	16-MAR-00	SALLIS, TOWN OF	915	10	82.3	870	35	240	264	40	264	MU	
K0044	MS-GW-15521	35	14N	04E	23-MAY-00	CAIN, WILLIAM	250	4	11	190	60	0	300	0	300	SB	
K0045	MS-GW-15522	35	14N	04E	23-JUL-00	CAIN, WILLIAM	90	4	12	60	30	0	300	0	300	SB	
K2000		26	14N	05E	30-OCT-62	MR B G FLEMING	279	2	18	274	6	6	0	0	0	DO	
K2001		26	14N	05E	30-OCT-62	MR B G FLEMING	279	2	18	274	6	6	0	0	0	DO	
K2002		35	14N	05E	18-JUN-64	PAUL EARLY	270	2	2	105	0	0	0	0	0	DO	
K2003		34	14N	05E	16-MAR-66	MATTIE BELL HARMON	69	2	2	63	6	6	0	0	0	DO	
K2004		17	14N	05E	08-APR-66	MR E. HUDGINS	345	2	2	50	50	252	0	0	0	DO	
K2005		21	14N	05E	25-JUL-66	MR. E. PERRY	155	2	2	32	143	12	0	0	0	DO	
K2006		24	14N	05E	07-SEP-66	MR. N.N. SIMPSON	297	2	2	60	189	0	0	0	0	DO	
K2007		24	14N	05E	13-SEP-66	MR. B. BORRELL	275	2	2	20	168	0	0	0	0	DO	
K2008		23	14N	05E	13-SEP-66	ATLAS STEWART	315	2	2	20	309	6	0	0	0	DO	
K2009		20	14N	05E	30-JAN-68	MRS. ADDINGTON	63	2	2	40	58	5	0	0	0	DO	
K2010		28	14N	05E	05-MAR-68	A TRUSS	359	2	2	72	256	0	0	.75	0	DO	
K2011		18	14N	05E	01-MAR-77	H.T. HAYOLD	337	2	2	255	0	0	0	.75	0	DO	
K2012		13	14N	05E	16-MAR-81	ALBERT HULL	83	2	2	30	73	10	0	1	0	DO	
K2013		12	14N	05E	19-MAR-81	ANTHONY TEAGUE	83	2	2	45	73	10	0	1	0	DO	
K2014		08	14N	05E	12-AUG-81	TOMMY BUFORD	320	2	2	45	255	10	0	.5	0	DO	
K2015		25	14N	05E	19-SEP-91	TORY TEAGUE	123	2	4	45	113	10	0	1	8	DO	
K2016		09	14N	05E	09-OCT-92	TOMMY BUFORD	190	4	4	60	180	10	0	.5	14	DO	
K2017		13	14N	05E	19-MAR-96	RICKY TEGUDS	85	2	2	25	75	10	0	.75	10	DO	
K2018		35	14N	05E	14-JUL-98	GREGORY HINES	140	4	4	60	130	10	0	.5	10	DO	
K2019		11	14N	05E	03-FEB-00	CLYDE DEAN WITT	90	2	2	15	80	10	0	1	10	DO	
K2020		01	14N	05E	27-APR-00	JAMES CROWDER	130	4	4	45	120	10	0	1	10	FC	
K2021		36	14N	05E	20-MAY-00	THOMAS BROWN	90	4	4	15	80	10	0	1	10	DO	
K2022		12	14N	05E	22-AUG-00	ROY SIMS	143	4	4	40	133	10	0	2	18	IR	