

ATTALA MISSISSIPPI BOARD OF WATER COMMISSIONERS

K 2001

WATER WELL DRILLERS LOG

10-30-62

Date: 10-30-62, 1962, Driller: Smith & Presley County Attala

(Name)

(1) Owner of Land: <u>Mr. R. K. Fleming</u> (Name)	Description & Color of Materials Sand, Clay, Red Clay, Shell, etc.	Thick- ness Feet	Depth Feet
<u>Rt. 1 Box 576 Dallas Miss</u> (Address)	<u>Green sand green clay mixture with black</u>	10	247
(2) Location: <u>NW 1/4, NW 1/4, Sec 4, T4R6</u>	<u>White sand with</u>	7	254
<u>2</u> miles <u>North</u> , of <u>Dallas</u> (distance) (direction) (Nearest Town)	<u>greenish tint</u>	7	254
(3) Topography: <u>table land</u> (Hilly) (Flat) (Level)	<u>water grade</u>	7	261
(4) Purpose of Well: <u>domestic</u> (Domestic Irrigation Municipal, Industrial, Other)	<u>greenish sand</u>	10	271
	<u>white sand</u>	8	279


Information upon completion of well:

- (1) Diameter 2 inches.
- (2) Total Depth 279 feet.
- (3) Water Level 18 feet below top of ground.
- (4) Cased to 274, Size 2x 1/4.
- (5) Screen: Size 1/4, Length 16.
- (6) Were any formations sealed against pollution?
_____ yes, _____ no.

If YES depth of formation _____

Why _____

Drillers Remarks: _____

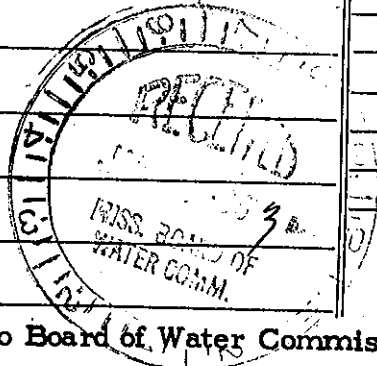

(Use Back Side)

Well No. 37

Mail this copy to Board of Water Commissioners 429 Miss. St. Jackson, Miss