


ATTALA MISSISSIPPI BOARD OF WATER COMMISSIONERS

K 2003  
3-16-66

WATER WELL DRILLERS LOG

Date: 3-16, 1966, Driller: Smith Forge & Welding County Attala  
Name

		Description & Color of Materials. Sand, Clay, Red Clay, Shell, etc.	Thick- ness Feet	Depth Feet
(1) Owner of Land: <u>Mathie Bell Herman</u> (Name)		<u>Red clay</u>	<u>17</u>	<u>17</u>
<u>P.O. Box 1 Sallas Miss</u> (Address)		<u>blue clay</u>	<u>40</u>	<u>57</u>
(2) Location: <u>lot 1/4</u> , <u>1/4</u> , Sec. <u>34</u> <u>N 4 R 5</u>		<u>black silt</u>	<u>7</u>	<u>64</u>
<u>in</u> miles <u>Sallas</u> , of _____ (distance) (direction) (Nearest Town)		<u>black clay</u>	<u>6</u>	<u>60</u>
(3) Topography: <u>flat</u> (Hilly) (Flat) (Level)		<u>gray sand</u>	<u>9</u>	<u>69</u>
(4) Purpose of Well: <u>domestic</u> (Domestic Irrigation Municipal, Industrial, Other)				
Information upon completion of well:				
(1) Diameter <u>2</u> inches.				
(2) Total Depth <u>69</u> feet.				
(3) Water Level <u>16</u> feet below top of ground.				
(4) Cased to <u>63</u> , Size <u>2</u>				
(5) Screen: Size <u>1/4</u> , Length <u>6'</u>				
(6) Were any formations sealed against pollution? _____ yes, <u>X</u> no.				
If YES depth of formation _____				
Why _____				
Drillers Remarks: _____				
_____				
_____				
_____				

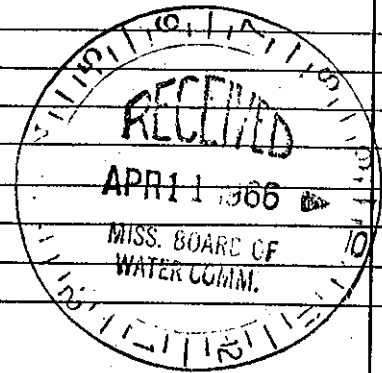

(Use Back Side)

Well No. 5

Mail this copy to Board of Water Commissioners 429 Miss. St. Jackson, Miss.