

ATTALA MISSISSIPPI BOARD OF WATER COMMISSIONERS

K 2004  
4-8-66

WATER WELL DRILLERS LOG

Date: 4-8, 1966, Driller: Thomas & Son County ATTALA  
(Name)

		Description & Color of Materials Sand, Clay, Red Clay, Shell, etc.	Thick- ness Feet	Depth Feet
(1) Owner of Land: <u>Mr. E. Hudgins</u> (Name)	<u>Durant, Miss.</u> (Address)	<u>Red Sand</u>	<u>60</u>	<u>0</u>
(2) Location: <u>NE 1/4, NW 1/4, Sec. 17 T4R5</u>	<u>2</u> miles <u>NE</u> , of <u>Durant</u> (distance) (direction) (Nearest Town)	<u>Sand w/ Chalk</u>	<u>30</u>	<u>60</u>
(3) Topography: <u>(Hilly)</u> (Flat) (Level)		<u>Good Coarse Sand</u>	<u>20</u>	<u>90</u>
(4) Purpose of Well: <u>(Domestic)</u> Irrigation Municipal, Industrial, Other		<u>Sand and Chalk</u>	<u>75</u>	<u>110</u>
		<u>Black Dirt</u>	<u>60</u>	<u>185</u>
		<u>mostly Rock</u>	<u>5</u>	<u>245</u>
		<u>Black Dirt</u>	<u>20</u>	<u>250</u>
		<u>Rock &amp; shell</u>	<u>25</u>	<u>270</u>
		<u>Green Sand w/ some shell</u>	<u>50</u>	<u>295</u>

Information upon completion of well:


- (1) Diameter 2 inches.
- (2) Total Depth 345 feet.
- (3) Water Level 50 feet below top of ground.
- (4) Cased to 252, Size 2"
- (5) Screen: Size \_\_\_\_\_, Length \_\_\_\_\_.
- (6) Were any formations sealed against pollution?  
\_\_\_\_\_ yes, ✓ no.

If YES depth of formation \_\_\_\_\_

Why \_\_\_\_\_

Drillers Remarks: \_\_\_\_\_

\_\_\_\_\_  
\_\_\_\_\_  
\_\_\_\_\_

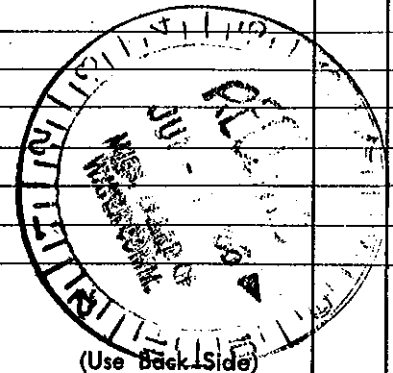

(Use Back Side)

Well No.

Mail this copy to Board of Water Commissioners 429 Miss. St. Jackson, Miss.