

Attala

K2005

MISSISSIPPI BOARD OF WATER COMMISSIONERS

7-66

WATER WELL DRILLERS LOG

Date: 7-25, 19 66, Driller: Thomas & Son County Attala

(1) Owner of Land:	Description & Color of Materials	Thick-ness Feet	Depth Feet
Mr. E. Perry (Name)	Dirt	15	0
M <sup>c</sup> Adams, Miss (Address)	Black Tirt	85	15
(2) Location: NE 1/4, NE 1/4, Sec. 21 T4R5	Fine Sand w/ chalk	40	100
3 miles N, of Sallis (distance) (direction) (Nearest Town)	Coarse Sand	15	140
(3) Topography:	with streaks of chalk		
(Hilly) (Flat) (Level)			
(4) Purpose of Well:			
Domestic Irrigation Municipal, Industrial, Other			

Information upon completion of well:


- (1) Diameter 2 inches.
- (2) Total Depth 155 feet.
- (3) Water Level 32 feet below top of ground.
- (4) Cased to 143', Size 2"
- (5) Screen: Size 60 G, Length 12'
- (6) Were any formations sealed against pollution?  
yes,  no.

If YES depth of formation

Why

Drillers Remarks:

Yield in gpm: 5  
Size pump: 1/2 H.P. Jet  
Type power: Elec.

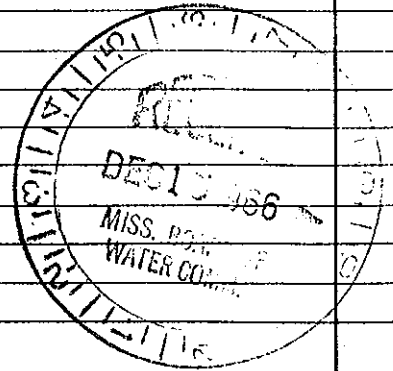

Mail this copy to Board of Water Commissioners 429 Miss. St. Jackson, Miss.