

Attala  
 K2006  
 9-66

MISSISSIPPI BOARD OF WATER COMMISSIONERS

WATER WELL DRILLERS LOG


Date: 9-7, 1966, Driller: Thomas & Son County Attala  
 (When well drilled) (Name) (Where well is located)

		Description & Color of Materials Sand, Clay, Red Clay, Shell, etc.	Thick- ness Feet	Depth Feet
(1) Owner of Land: <u>Mr. W. V. Simpson</u> (Name)		<u>Red Clay</u>	<u>10</u>	<u>0</u>
<u>Sallis, Miss.</u> (Address)		<u>Chalk w/ Sand</u>	<u>74</u>	<u>10</u>
(2) Location: <u>NW 1/4, SW 1/4, Sec 24 T42R 5E</u>		<u>Real coarse Sand</u>	<u>60</u>	<u>84</u>
<u>2</u> miles <u>N</u> of <u>Sallis</u> (distance) (direction) (Nearest Town)		<u>Black Dirt</u>	<u>145</u>	<u>144</u>
(3) Topography: <u>(Hilly)</u> (Flat) (Level)		<u>Rock &amp; Shell</u>	<u>51</u>	<u>189</u>
(4) Purpose of Well: <u>Domestic</u> Irrigation Municipal, Industrial, Other)		<u>Face Runner</u>	<u>12</u>	<u>240</u>
		<u>Green Sand w/ some Rock</u>	<u>37</u>	<u>260</u>

Information upon completion of well:

- (1) Diameter 2 inches.
- (2) Total Depth 297 feet.
- (3) Water Level 60 feet below top of ground.
- (4) Cased to 189', Size 2"
- (5) Screen: Size None, Length \_\_\_\_\_
- (6) Were any formations sealed against pollution?  
 \_\_\_\_\_ yes, ✓ no.

If YES depth of formation \_\_\_\_\_  
 Why \_\_\_\_\_  
 Drillers Remarks: \_\_\_\_\_  
 Yield in gpm: 10  
 Size pump: 3/4 H.P. 2stg.  
 Type power: Elec.

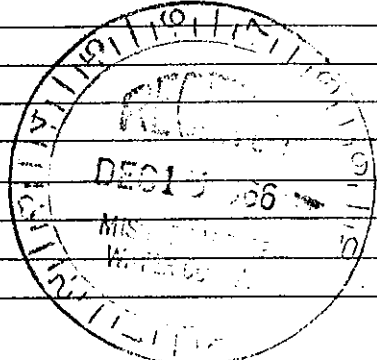

Mail this copy to Board of Water Commissioners 429 Miss. St. Jackson, Miss.